
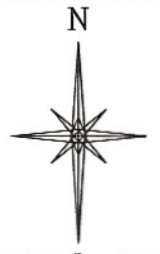


R. 94 W.

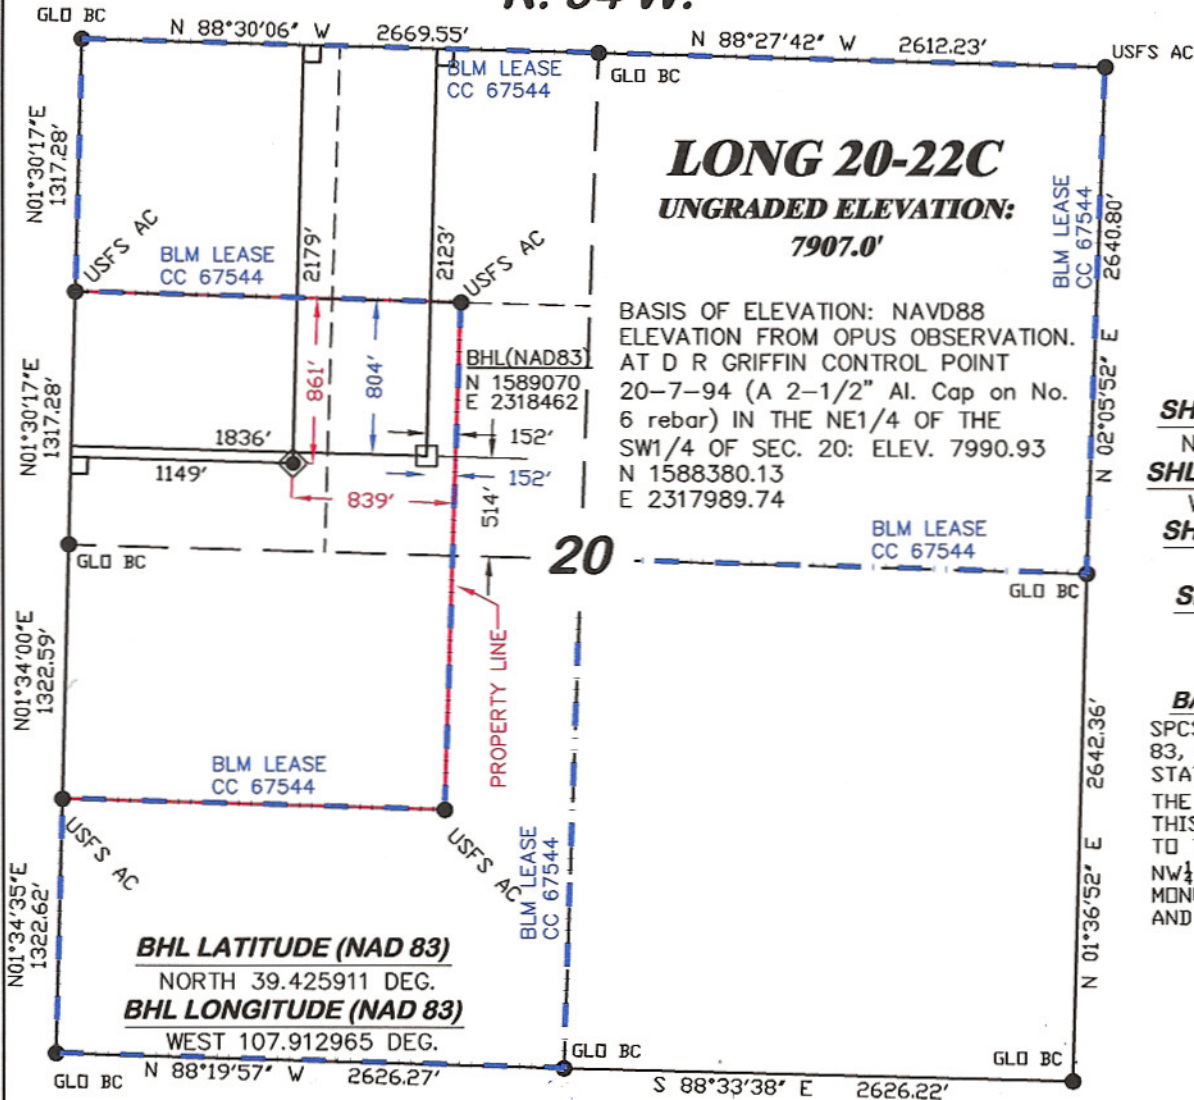

SCALE: 1" = 1000'
T. 7 S.

LONG 20-22C
UNGRADED ELEVATION:
7907.0'

BASIS OF ELEVATION: NAVD88
ELEVATION FROM OPUS OBSERVATION.
AT D R GRIFFIN CONTROL POINT
20-7-94 (A 2-1/2" Al. Cap on No.
6 rebar) IN THE NE1/4 OF THE
SW1/4 OF SEC. 20: ELEV. 7990.93
N 1588380.13
E 2317989.74

SHL LATITUDE (NAD 83)
NORTH 39.425756 DEG.
SHL LONGITUDE (NAD 83)
WEST 107.915402 DEG.
SHL NORTHING (NAD83)
1589031.35
SHL EASTING (NAD83)
2317772.64

BASIS OF BEARING
SPCS CO CENTRAL NAD
83, BASED ON NGS TRIG.
STATION "FABER"
THE BASIS OF BEARINGS FOR
THIS SURVEY IS REFERENCED
TO THE NORTH LINE OF THE
NW1/4 OF SECTION 20, BEING
MONUMENTED WITH GLO BC'S
AND BEARING N 88° 30' 06" W.

LEGEND

- ◆ WELL LOCATION
- FOUND MONUMENT
- L DENOTES 90° TIE
- BHL LOCATION



SURVEYOR'S STATEMENT

I, Ronald C. Rennke, an employee and agent on behalf of D.R. GRIFFIN & ASSOCIATES, INC. state the plat hereon is a correct representation of a survey made under my supervision on September 18, 2008 of the shown LONG 20-22C staked on the ground as shown hereon.

NOTES


GPS OPERATOR RICHARD BULLEN
OBSERVED A PDOP OF 2.5.

ALL GPS OBSERVATIONS ARE IN
COMPLIANCE WITH COGCC RULE NO. 215.

HIGH PLATEAU DESERT
2-TRACK ROAD WITHIN 400' RADIUS
OF WELL SITE SEE EXHIBIT 1B.

SURFACE USE IS NATIVE WOODS, NON-CROP & RANGELAND.

20F PAD

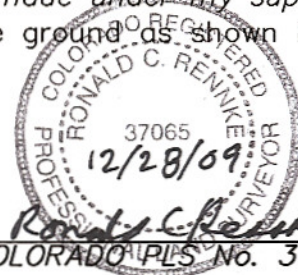

COLORADO PLS No. 37065



DR GRIFFIN & ASSOCIATES, INC.
(307) 362-5028 1414 ELK ST., ROCK SPRINGS, WY 82901

**PLAT OF DRILLING LOCATION IN THE
SW 1/4 OF NW 1/4 OF SECTION 20
FOR NOBLE ENERGY, INC.**

DATE DRAWN: 9/22/08-RAB

SCALE: 1" = 1000'

REVISED: 12/15/09 - DEH

JOB No. 15455

CHANGE DATUM NAD83

EXHIBIT 1

**2179' F/NL & 1149' F/WL, SECTION 20,
T. 7 S., R. 94 W., 6th P.M.
GARFIELD COUNTY, COLORADO**