


Lat40°, Inc. 1635 Foxtrail Drive, Suite 325 Loveland, CO 970-776-3321

## MULTI-WELL PLAN

WIP PC D06-30D, 31

THIS MAP DOES NOT REPRESENT A BOUNDARY SURVEY

SECTION: 1  
TOWNSHIP: 3N  
RANGE: 65W

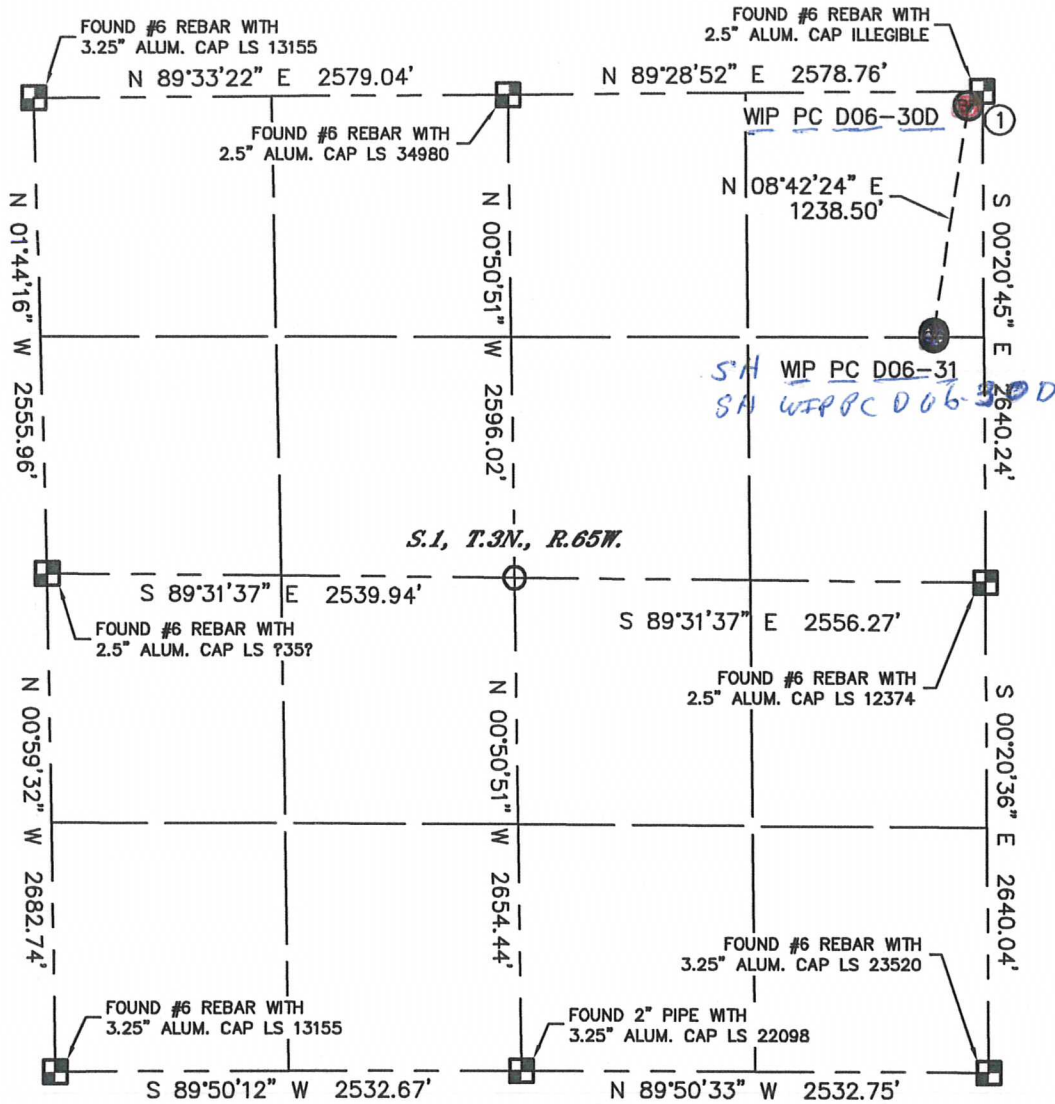

①

-BOTTOM HOLE-  
WIP PC D06-30D  
75' FNL  
75' FEL  
LAT-40.26128°N  
LONG-104.60271°W


### LEGEND



= ALIQUOT MONUMENT AS DESCRIBED



= CALCULATED POSITION

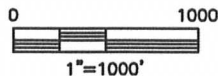

Lat40°, Inc. 1635 Foxtrail Drive, Suite 325 Loveland, CO 970-776-3321

## MULTI-WELL PLAN

WIP PC D06-30D, 31

SECTION: 1  
TOWNSHIP: 3N  
RANGE: 65W

