

Job # 12008 Handke #3

Inv # 1817

High Prairie Surveying of Kiowa, Colorado has in accordance with a request from **Robert Anderson, Overland Resources** has determined the location of **Handke #3** to be 638 feet FSL, and 634 feet FEL, (90° off Section lines) of SECTION **10**, Township **3s**, Range **64w** of the 6th Principal Meridian, **Adams County**, Colorado.

Date: Staked on 1/19/12 drawn on 1/20/12.

Re: Staked by Keith Westfall


Drawn: Drawn by Elijah Frane

# Location Drawing



There are no apparent improvements within 400' of proposed well pad.

Overland Resources  
SE1/4 Sec. 10-3s-64w  
Handke #3  
Adams Co., Colorado

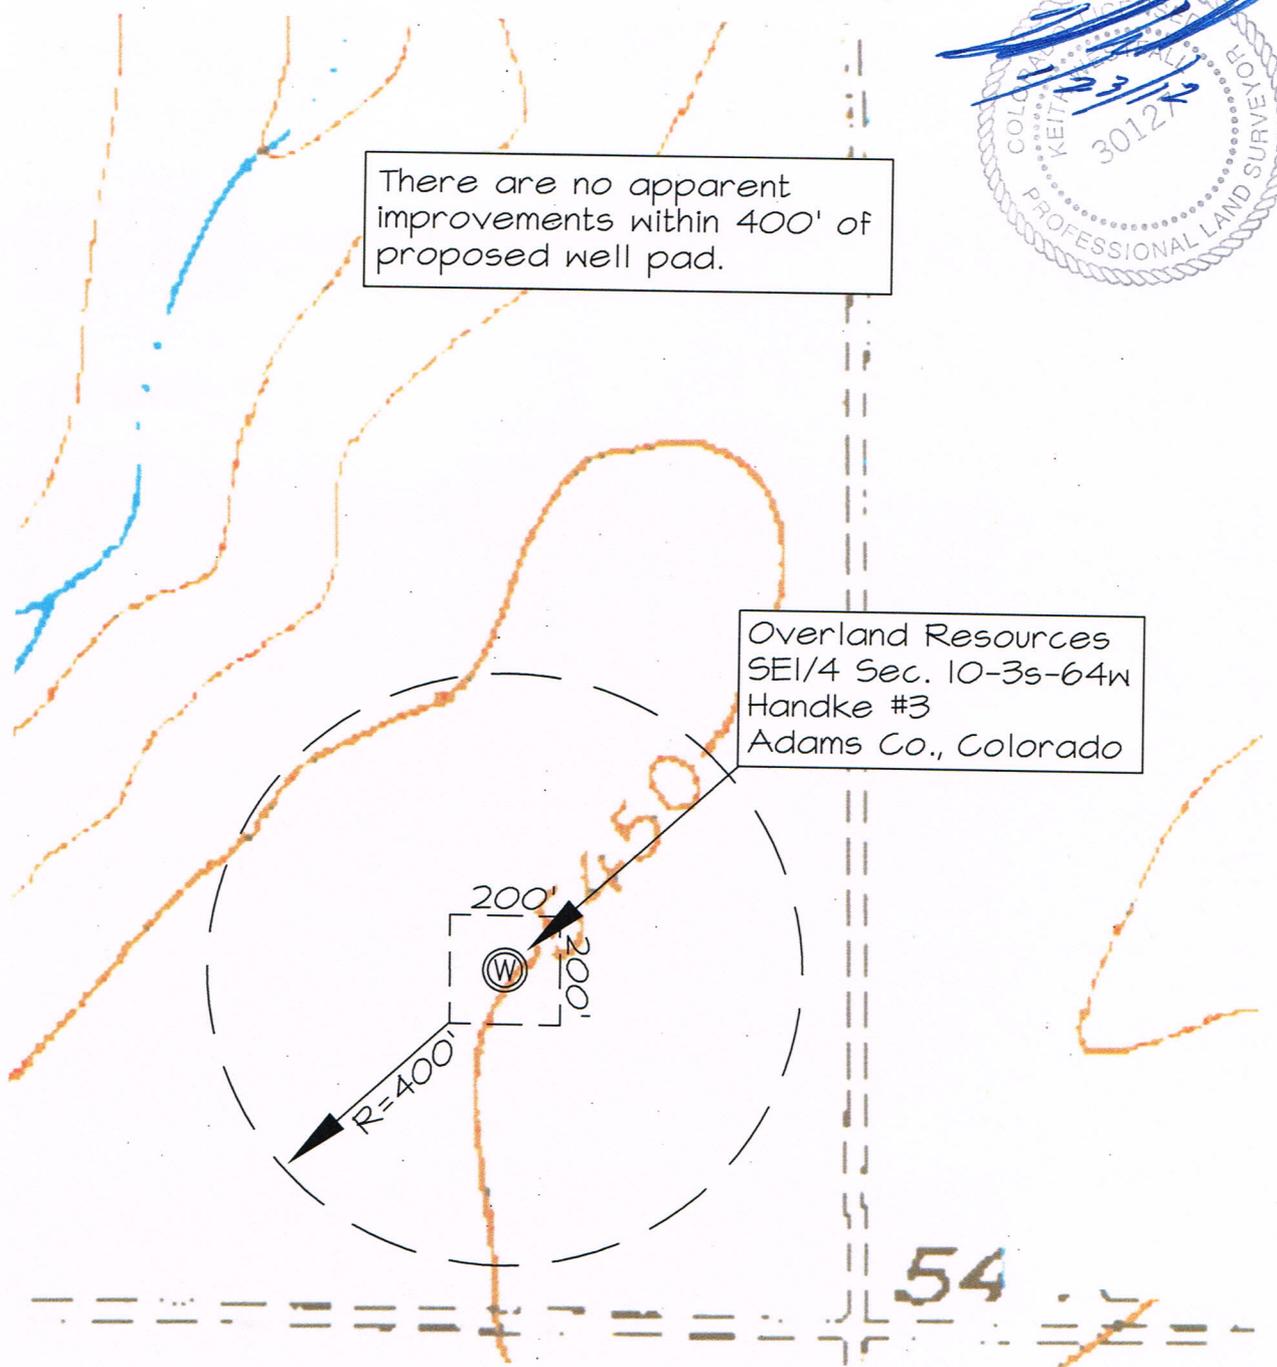

54