

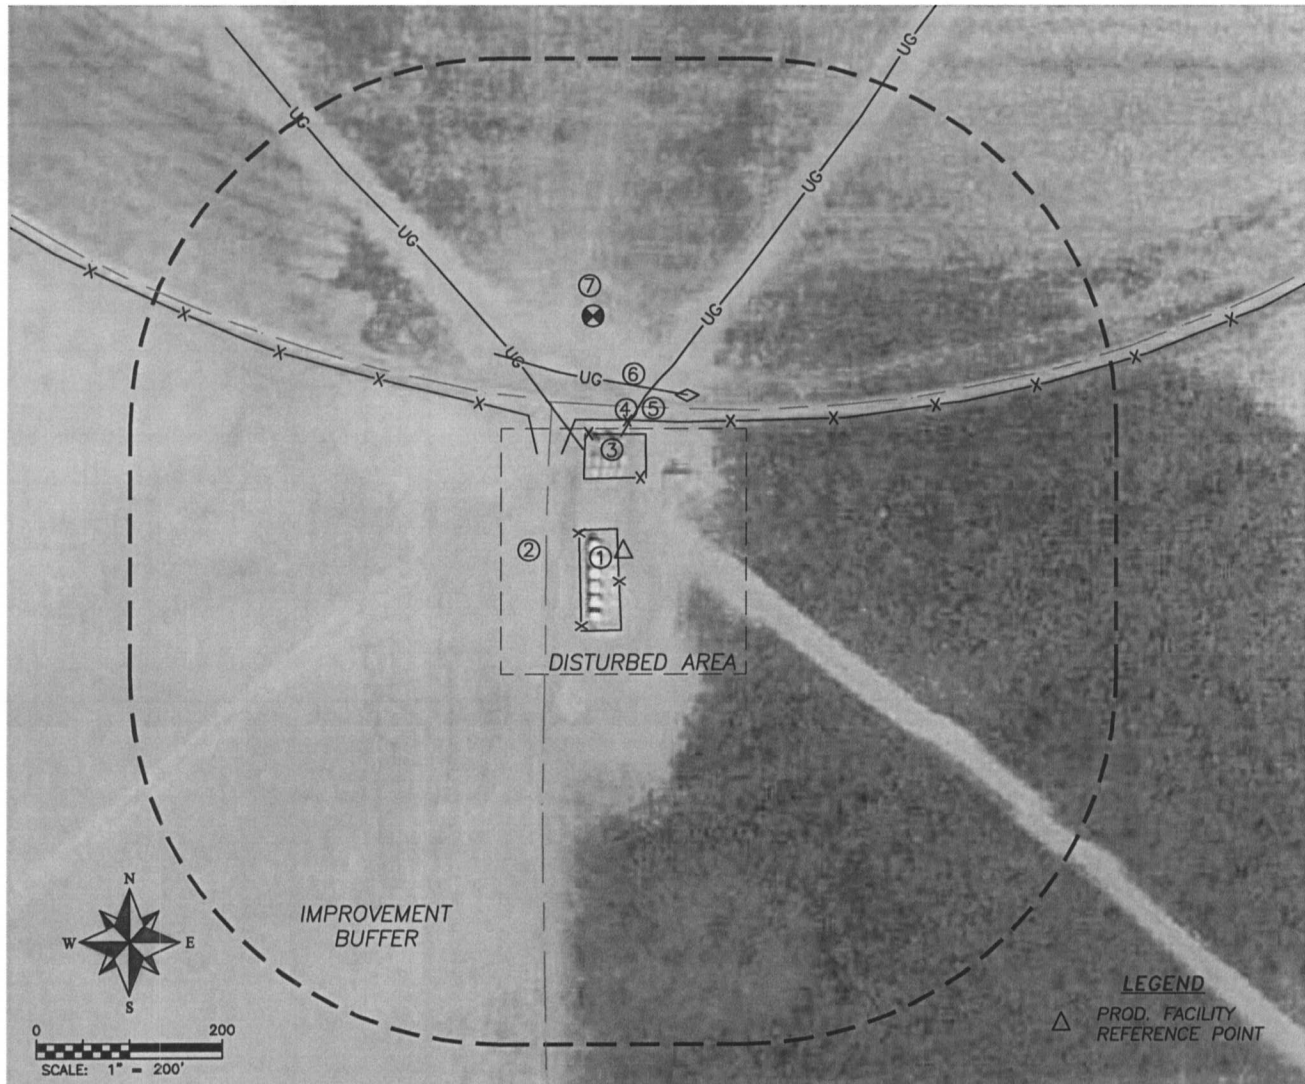
DALEY LAND SURVEYING, INC.

PARKER, CO. 80134

303 953 9841

PRODUCTION FACILITY LOCATION DRAWING DECHANT H36-24 & DECHANT H36-33

SECTION 36, TOWNSHIP 3 NORTH, RANGE 65 WEST OF THE 6TH PRINCIPAL MERIDIAN

**REFERENCE POINT LOCATION:**

LATITUDE: N40.17718°
 LONGITUDE: W104.61689°
 ELEV.: 4826'
 PDOP.: 1.4
 FOOTAGE: 1045' FSL, 1337' FWL
 QTR/QTR: SE4/SW4
 DATE: 10/13/2011

ASSOCIATED EXISTING WELLS:

SPIKE ST. GWS 36-12 & 36-13
 SPIKE ST. GWS H36-11J
 SPIKE ST. GWS H36-14
 DECHANT ST. H36-11D, 20D,
 21D, & 32D

ASSOCIATED NEW WELLS:

DECHANT H36-24 & H36-33

DISTANCE TO NEAREST:

BUILDING: 4390'± SE
 PUBLIC ROAD: 3898'± E
 OVERHEAD UTILITY: 3958'± E
 RAILROAD: 5280'±
 PROP. LINE: 1045'± S

EXISTING FACILITIES:

TANKS: 6
 SEPARATORS: 4
 EMF: 1
 VOC: 2

IMPROVEMENTS

1. PROD. FACILITY:	6'± W
2. FIELD ROAD:	84'± W
3. GAS LINE:	125'± N
	117'± NE
4. WIRE FENCE:	142'± N
5. FIELD ROAD:	157'± N
6. GAS LINE:	178'± N
7. GAS WELL:	256'± N