High Prairie Survey Co.

Physical Address: 345 Comanche St.
Mail to: Box 384 Kiowa, CO 80117
Ph. 303-621-8672 - Fax 303-621-2717
www.highprairiesurvey.com

Job # 12008 Handke #4

Inv # 1818

High Prairie Surveying of Kiowa, Colorado has in accordance with a request from **Robert Anderson, Overland Resources** has determined the location of **Handke #4** to be 1983 feet FSL, and 1984 feet FEL, (BHL 1286' FSL-1723' FEL) , (90° off Section lines) **of** SECTION **10**, Township **3s**, Range **64w** of the 6th Principal Meridian, **Adams County**, Colorado.

Date: Staked on 1/19/12 drawn on 1/20/12.

Re: Staked by Keith Westfall
Drawn: Drawn by Elijah Frane

Basis of Elevation Spot: USGS BM = VALENTE, PID = AI3084, H-Order = GPS OBS, V-Order = GPS OBS, Stability = B, P-DOP = 2.6, Sats = 7 US NAD 83 CO-N, Lat. = 39.83921, Long. = W104.48927, Elevation = 5322.0' gr. (us FT).

Notes: There are no apparent improvements within 400 ft of proposed well pad.
The ground elevation at staked location = 5444.55' gr.
This drawing does not represent a monumented survey or Land Survey Plat.
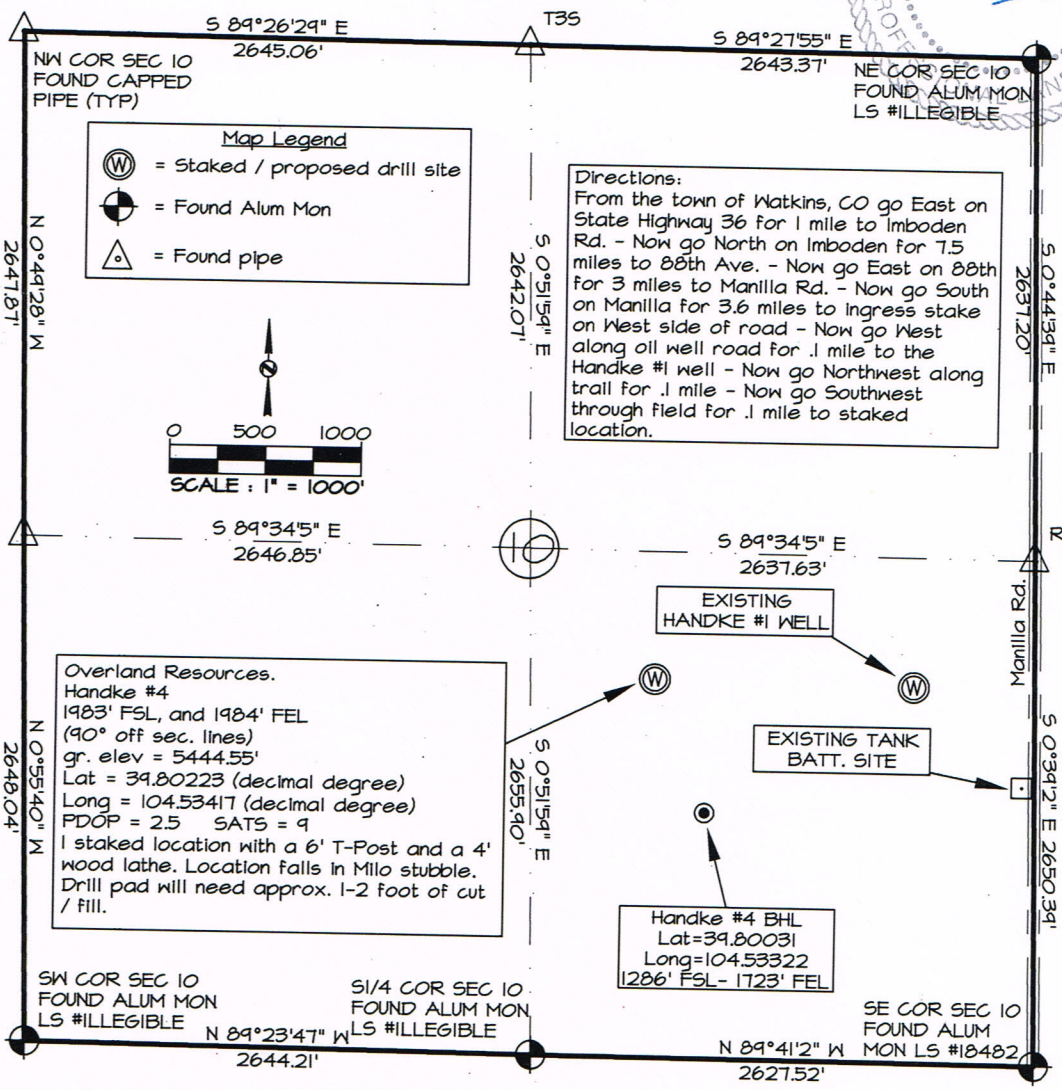
Basis of Bearing: Bearings were determined based on the South line of the Southeast 1/4 of Section 10 to bear N 89°41'02" W with all other bearings contained herein relative thereto.