



Physical Address: 401 Arapahoe St.
Mail to: Box 384 Kiowa, CO 80117
Ph. 303-621-8672 - Fax 303-621-2717
www.highprairiesurvey.com

Job: 10178 Mahalo #9

Inv # 1808

High Prairie Surveying of Kiowa, Colorado has in accordance with a request from **Jack Fincham, Wiepking Fullerton Energy** has determined the location of **Mahalo #9** to be **2080 feet FSL**, and **1980 feet FEL**, (90° off Section lines) of **SECTION 29**, Township **10s**, Range **55w** of the 6th Principal Meridian, **Lincoln County**, Colorado.

Date: Staked on 1-12-12 drawn on 1-16-12.


Re: Staked by Keith Westfall

Drawn: Drawn by Elijah Frane

Reference Area



Reference Area
Lat= 39.14981 (Dec. Degree)
Long=103.57591 (Dec. Degree)

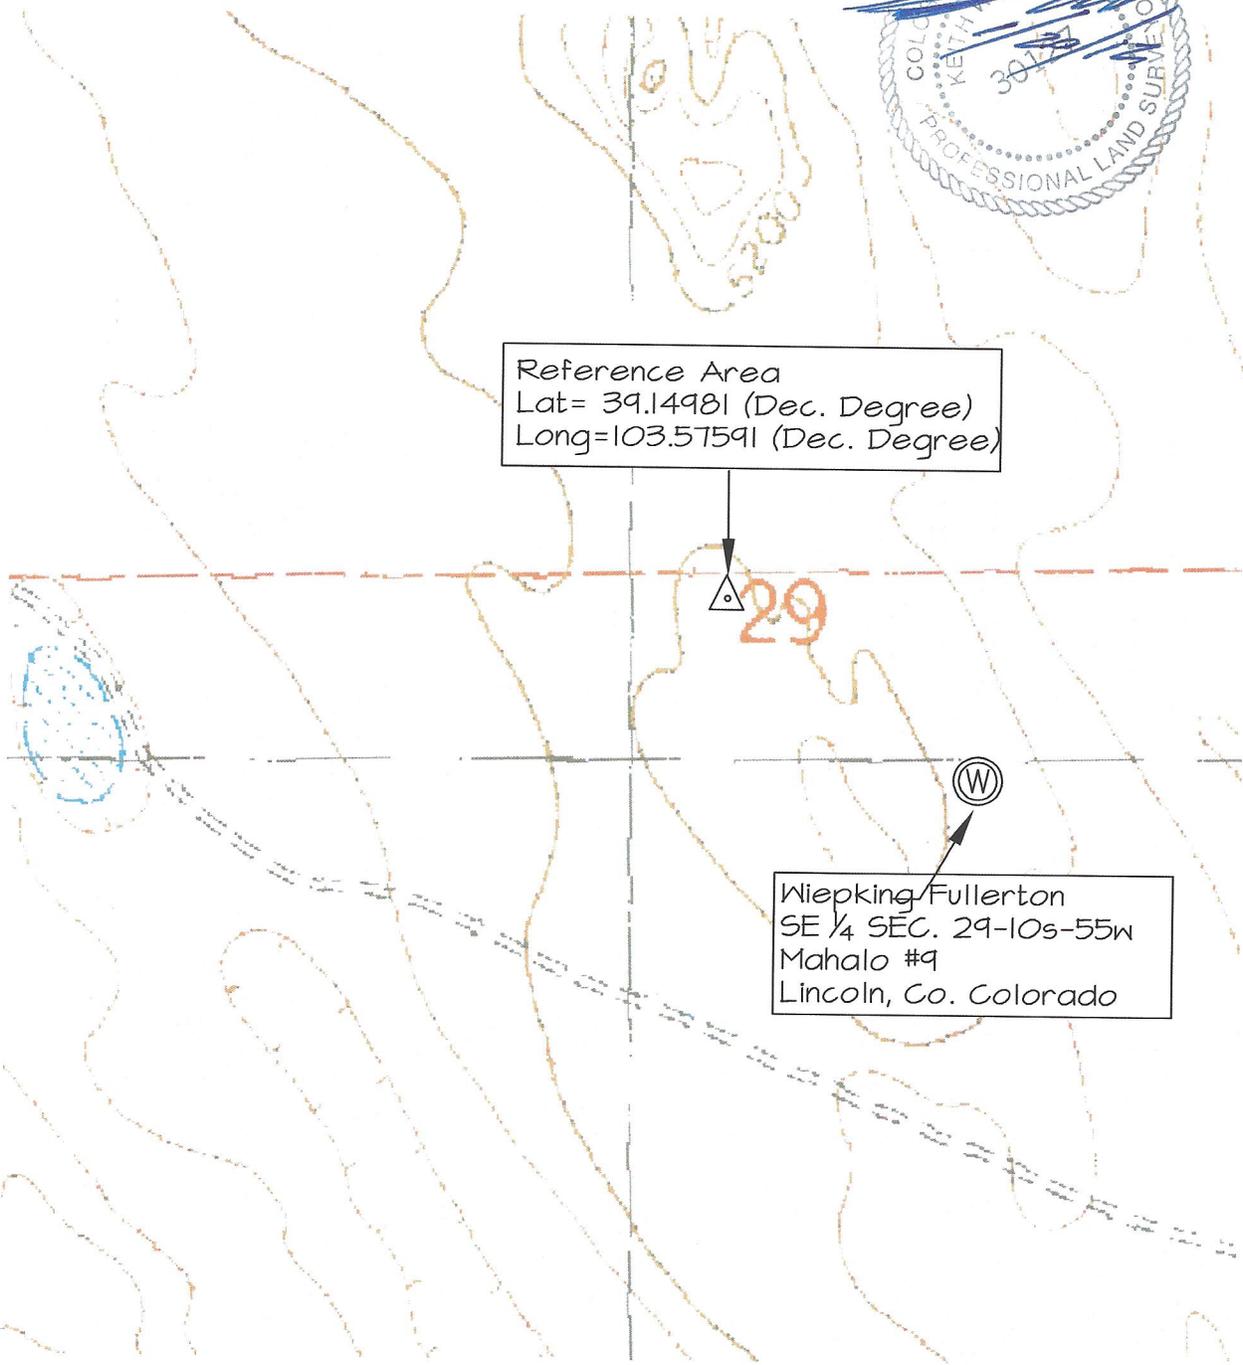

Wiepking Fullerton
SE 1/4 SEC. 29-10s-55w
Mahalo #9
Lincoln, Co. Colorado