


WELL LOCATION CERTIFICATE

NW CRN SEC. 26
1" PIPE - REPLACED
W/ 2.5" AC LS 24657

SECTION 26, TOWNSHIP 1 SOUTH, RANGE 58 WEST, 6TH P.M.

NE CRN SEC. 26
2.5" AC LS 13895

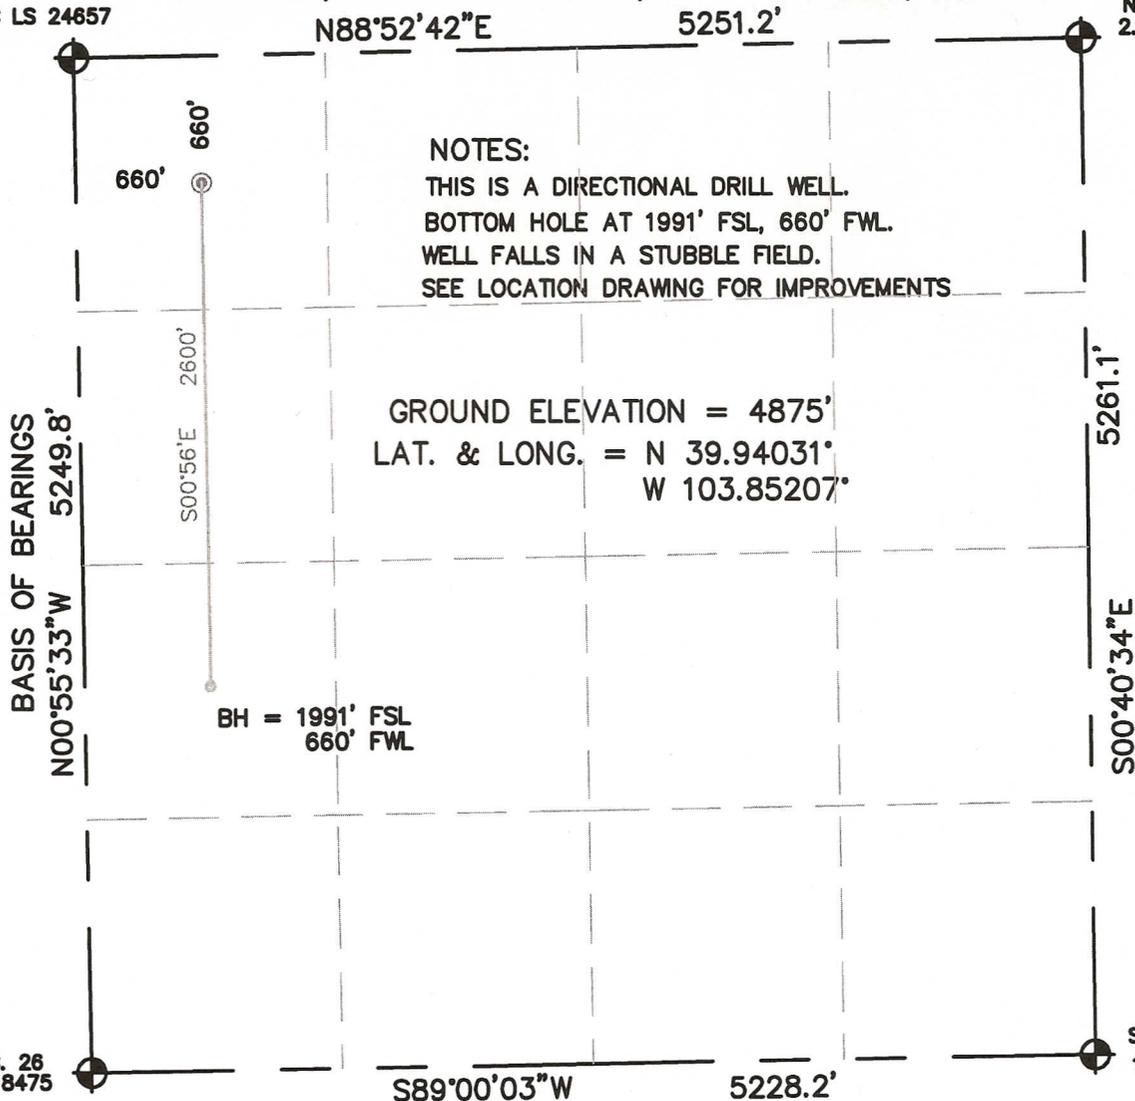

NOTES:
THIS IS A DIRECTIONAL DRILL WELL.
BOTTOM HOLE AT 1991' FSL, 660' FWL.
WELL FALLS IN A STUBBLE FIELD.
SEE LOCATION DRAWING FOR IMPROVEMENTS

GROUND ELEVATION = 4875'
LAT. & LONG. = N 39.94031°
W 103.85207°

BH = 1991' FSL
660' FWL


SW CRN SEC. 26
2.5" AC LS 18475

SE CRN SEC. 26
1" CAPPED PIPE

I HEREBY STATE TO SOUTHWESTERN ENERGY CO. THAT THE SURFACE LOCATION OF THE WELL EWERTZ FARMS 1-58 #1-26P IS LOCATED 660' FNL & 660' FWL, SEC. 26, T1S, R58W, 6PM.



- LEGEND**
- = FOUND/SET MONUMENT
 - = PROPOSED WELL

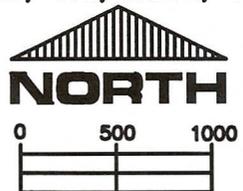

SCALE 1" = 1000'

ELEVATION SOURCE = USGS 7.5' QUAD.MAP CONTOURS
NGVD 1929 DATUM.

LAT. & LONG. ARE DIFFERENTIALLY CORRECTED (WGS'84)
USING (DGPS) WITH A (PDOP) VALUE OF 2.7.

THOMAS G. CARLSON, PLS 24657
HORSESHOE SURVEYING, LLC

SHOWN DISTANCES ARE FIELD MEASURED - EXTERIOR SECTION LINES
ARE DRAWN TO SCALE (BEST APPROX. OR FOUND MONUMENT).

THIS IS NOT A MONUMENTED BOUNDARY SURVEY, IT IS ONLY A DRAWING INTENDED TO DEPICT THE WELL LOCATION TO SECTION LINES. DISTANCES TO WELL SHOWN PERPENDICULAR TO SECTION LINES.

PREPARED BY:	HORSESHOE SURVEYING, LLC PO BOX 150458 LAKEWOOD, CO 80215 (720)872-0196	WELL NAME:	EWERTZ FARMS 1-58 #1-26P	
DRAWING DATE:	2-1-12	LOCATION:	ADAMS COUNTY, CO NW1/4, SEC. 26, T1S, R58W, 6TH P.M.	
FIELD DATE:	12-17-11	BY:	TGC	CHKD:
		JOB NO.		SHEET NO. 1 OF 1