
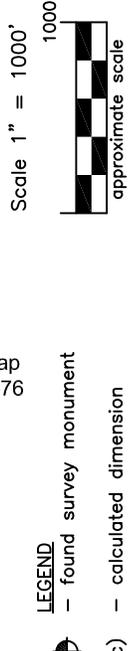


PLS Group, LLC
 109 Coronado Ct. - Bldg. 7
 Fort Collins, Colorado 80525
 P. 970-282-3446 Fx. 970-377-6767

WELL LOCATION CERTIFICATE

THIS MAP DOES NOT REPRESENT A BOUNDARY SURVEY

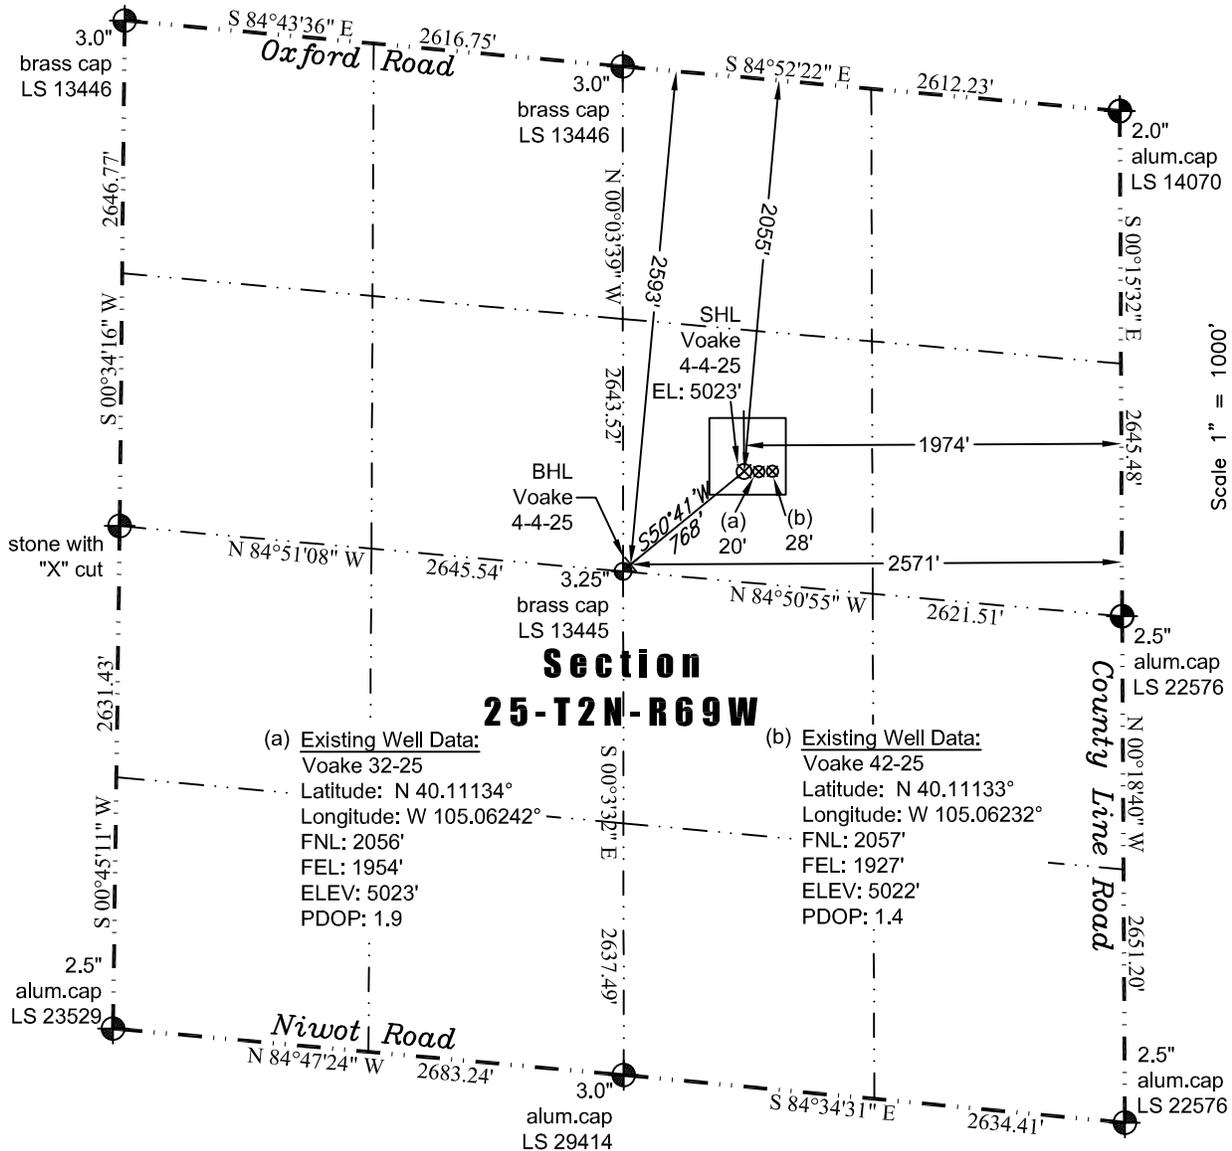

- (a) Existing Well Data:
 Voake 32-25
 Latitude: N 40.11134°
 Longitude: W 105.06242°
 FNL: 2056'
 FEL: 1954'
 ELEV: 5023'
 PDOP: 1.9
- (b) Existing Well Data:
 Voake 42-25
 Latitude: N 40.11133°
 Longitude: W 105.06232°
 FNL: 2057'
 FEL: 1927'
 ELEV: 5022'
 PDOP: 1.4


In accordance with a request from Jay Knutson of EnCana Oil & Gas (USA) Inc., PLS Group, LLC has determined the location of the **Voake 4-4-25** well site to be SHL: 2055' FNL and 1974' FEL, (BHL 2593' FNL and 2571' FEL), as measured at ninety (90) degrees from the section lines of Section 25, Township 2 North, Range 69 West of the 6th Principal Meridian, Boulder County Colorado.

Proposed Surface Hole Data:
 Latitude: N 40.11135° (BHL: N 40.11002°)
 Longitude: W 105.06249° (BHL: W 105.06462°)
 PDOP: 1.4

Nearest:
 Building 900' southwest Above Ground Utility 1,944' east
 Public Road 1,960' east Railroad 16,495 northwest
 Property Line 578' south Well Window: SHL is 121' inside
 Existing Well: Voake 32-25 20' east

- Notes:**
- 1) Bearings and distances based on NAD 83 Colorado North State Plane Coordinates using RTK GPS observations taken 8/12/11 by operator Tom Winans.
 - 2) Conversion factor to ground (1.000276491).
 - 3) Elevations based on NAVD 88 GPS heights and Geoid 2003 corrections.
 - 4) See Location Drawing for visible improvements within 400 feet of Pad Site.
 - 5) The surface use is cultivated field.

NOTICE: According to Colorado law you must commence any legal action based upon any defect in this W.L.C. within three years after you first discover such defect. In no event may any action based upon any defect in this W.L.C. be commenced more than ten years from this said date of the certification shown hereon.

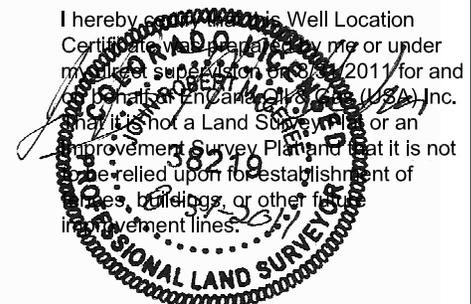

John Robert McGehee LS#38219
 Well: Voake 4-4-25 WLC