


JR Land Surveying, LLC
 8114 Northstar Drive
 Windsor, Colorado 80528
 P. 970-576-4641

WELL LOCATION CERTIFICATE

THIS MAP DOES NOT REPRESENT A BOUNDARY SURVEY

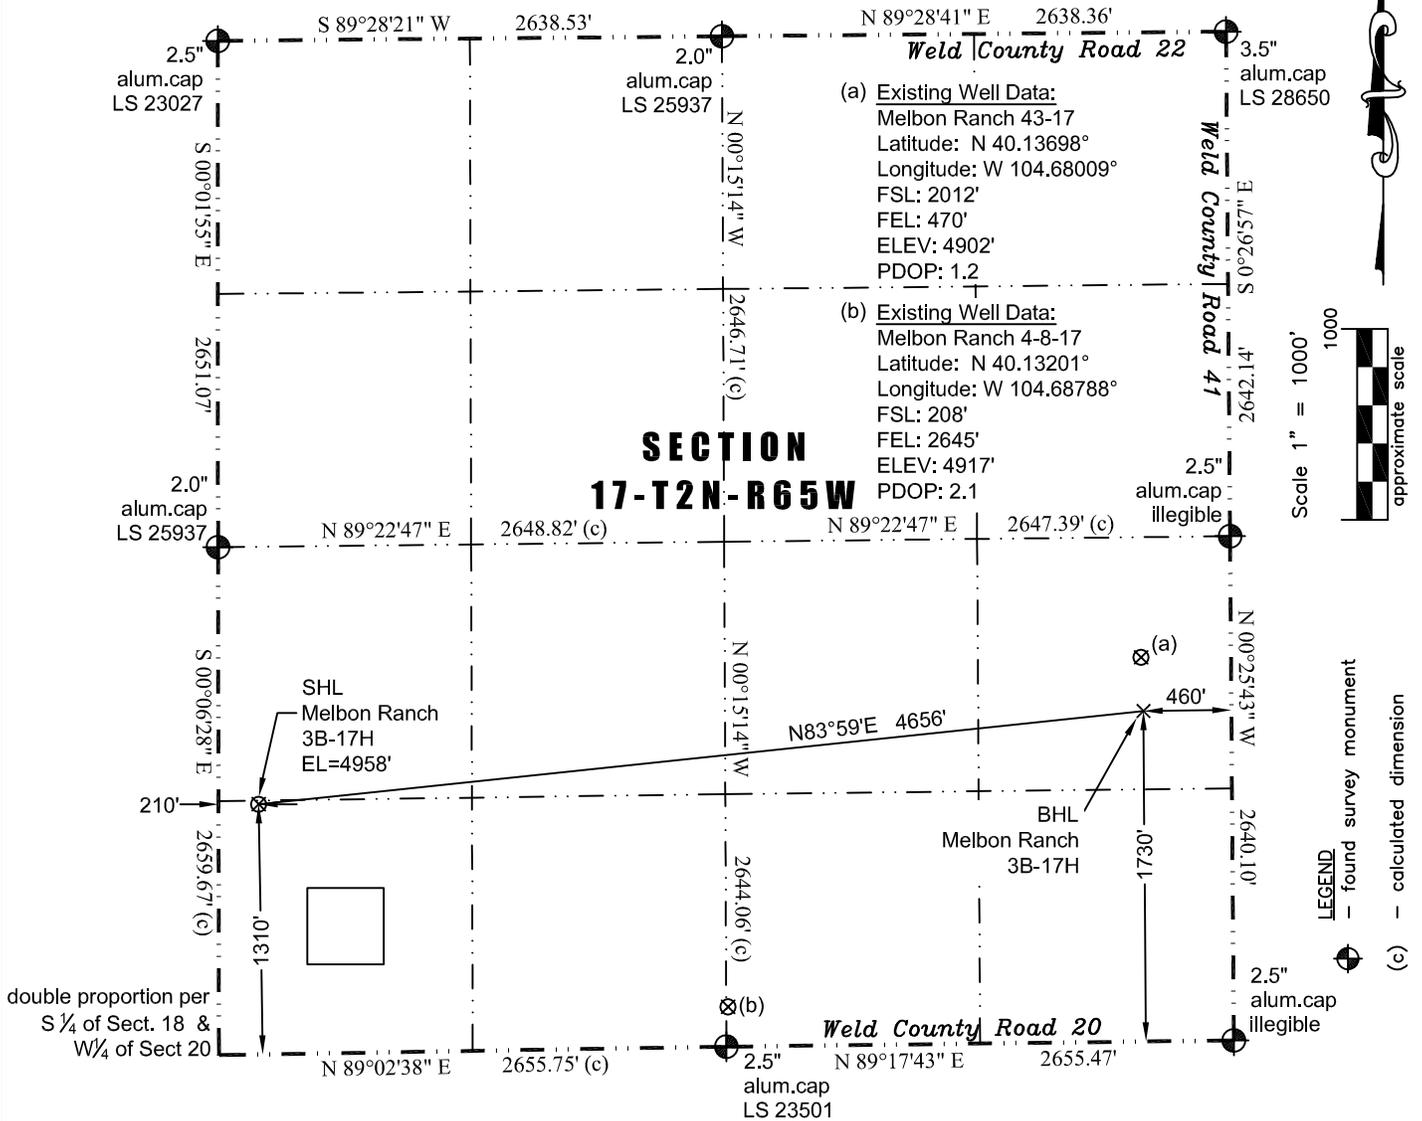

In accordance with a request from Jay Knutson of EnCana Oil & Gas (USA) Inc., JR Land Surveying, LLC has determined the location of the **Melbon Ranch 3B-17H** well site to be SHL: 1310' FSL and 210' FWL, (BHL 1730' FSL and 460' FEL), as measured at ninety (90) degrees from the section lines of Section 17, Township 2 North, Range 65 West of the 6th Principal Meridian, Weld County Colorado.


Proposed Surface Hole Data:

Latitude: N 40.13498° (BHL: 40.13620°)
 Longitude: W 104.69663° (BHL: 104.68006°)
 PDOP: 1.7

Nearest:

Building 1,544' northwest	Above Ground Utility 3,883' southeast
Public Road 1,293' south	Railroad 26,782' southeast
Property Line 210' west	Well Window: SHL is 507' outside
Existing Well: Hudco #16-18, 1,158' southwest	

I hereby certify that this Well Location Certificate was prepared by me or under my direct supervision on 2/24/2012 for and on behalf of EnCana Oil & Gas (USA) Inc. That it is not a Land Survey Plat or an Improvement Survey Plat and that it is not to be relied upon for establishment of fences, buildings, or other future improvement lines.

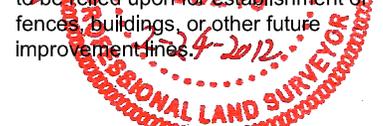

John Robert McGehee LS#38219
 Well: Melbon Ranch 3B-17H WLC

- Notes:**
- 1) Bearings and distances based on NAD 83 Colorado North State Plane Coordinates using RTK GPS observations taken 2/22/12 by operator J.R. McGehee.
 - 2) Conversion factor to ground (1.000273817).
 - 3) Elevations based on NAVD 88 GPS heights and Geoid 2003 corrections.
 - 4) See Location Drawing for visible improvements within 400 feet of Pad Site.
 - 5) The surface use is irrigated corn field.

NOTICE: According to Colorado law you must commence any legal action based upon any defect in this W.L.C. within three years after you first discover such defect. In no event may any action based upon any defect in this W.L.C. be commenced more than ten years from this said date of the certification shown hereon.