


WELL LOCATION CERTIFICATE

THIS MAP DOES NOT REPRESENT A BOUNDARY SURVEY

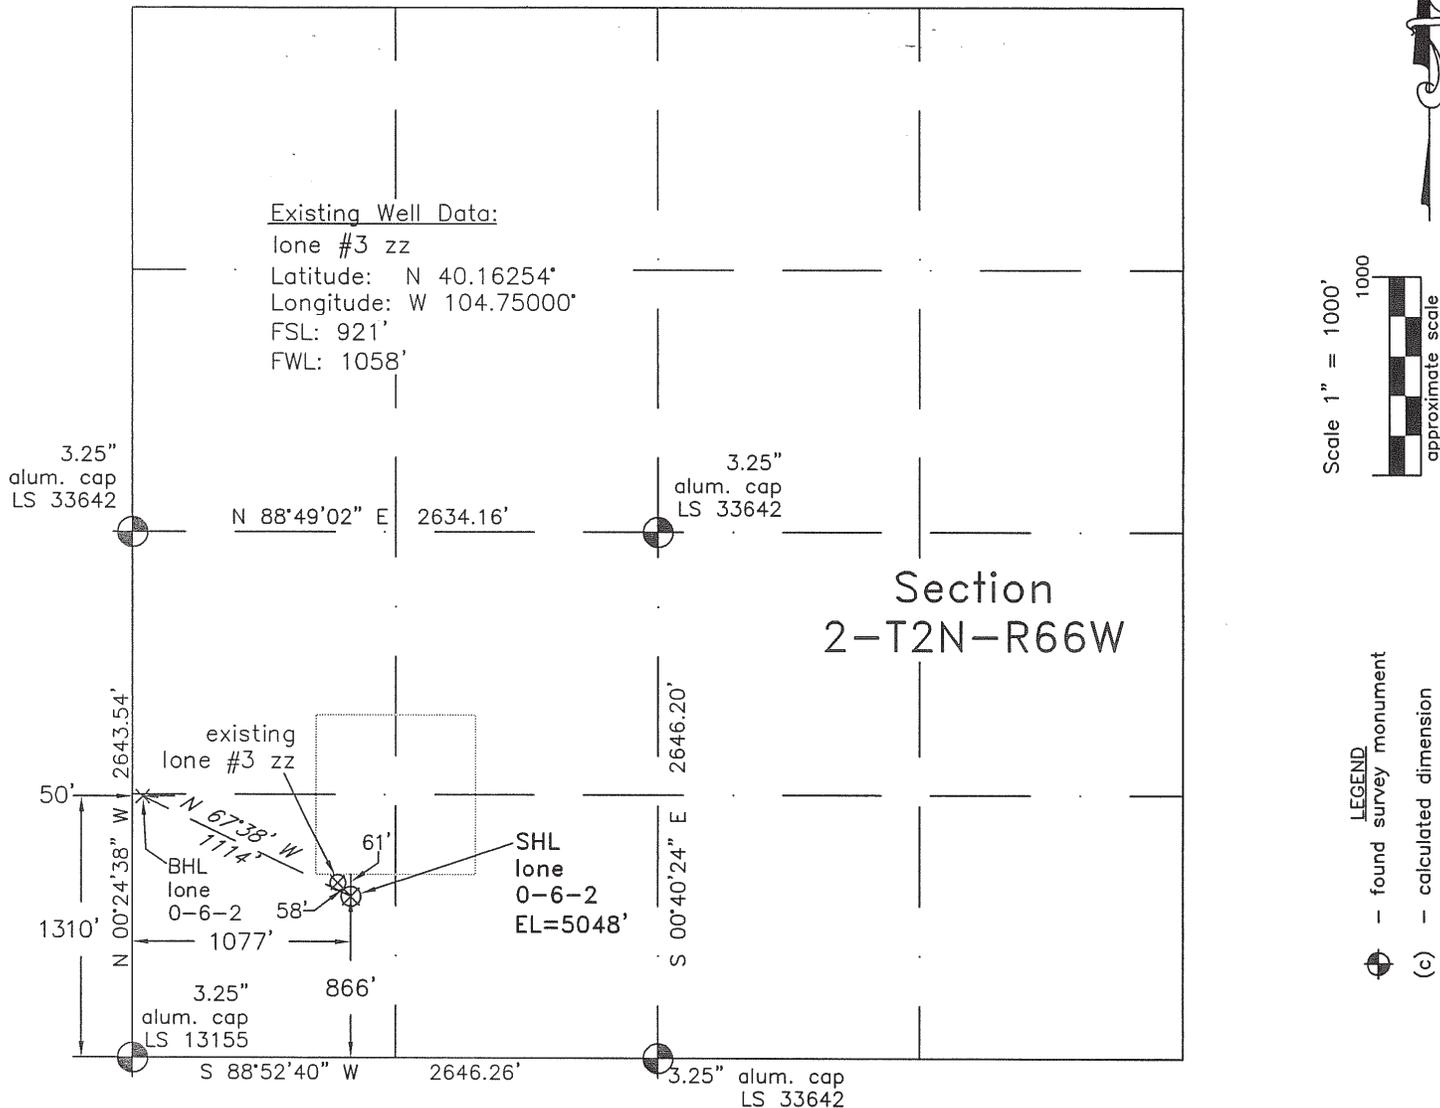

In accordance with a request from Dave Bale of EnCana Oil & Gas (USA) Inc., Frederick Land Surveying, Inc. has determined the location of the **lone 0-6-2** well site to be SHL: 866' FSL and 1077' FWL, BHL (1310' FSL and 50' FWL) as measured at ninety (90) degrees from the section lines of Section 2, Township 2 North, Range 66 West, 6th Principal Meridian, Weld County, CO.

Proposed Surface Hole Data:

Latitude: N 40.16239° BHL(40.16357°)
 Longitude: W 104.74994° BHL(104.75361°)
 Nearest: Building 5,064' northwest Above Ground Utility 4,038' east
 Public Road 4,515' northwest Railroad 17,600' west
 Property Line 866' south
 PDOP: 1.9

Notes:

- 1) Bearings and distances based on NAD 83 Colorado North State Plane Coordinates using RTK GPS observations taken 2/4/10 by operator Craig Burke.
- 2) Conversion factor to ground (1.000275398).
- 3) Elevations based on NAVD 88 GPS heights and Geoid 2003 corrections.
- 4) See improvement map for visible improvements within 400 feet.
- 5) The location falls on agricultural land.

NOTICE: According to Colorado law you must commence any legal action based upon any defect in this W.L.C. within three years after you first discover such defect. In no event may any action based upon any defect in this W.L.C. be commenced more than ten years from this said date of the certification shown hereon.

I hereby certify that this Well Location Certificate was prepared by me or under my direct supervision on 2/19/10 for and on behalf of EnCana Oil & Gas (USA) Inc. and that it is a Land Survey Plat or an Improvement Survey Plat and that it is not to be relied upon for establishment of fences, boundaries, or other future improvement lines.

Alex Ronald
 Alex Ronald, Registered Professional Surveyor
 License # 34176
 Job #: 09034.044 2-19-2010