


Lat40°, Inc. 1635 Foxtrail Drive, Suite 325 Loveland, CO 970-776-3321

PRODUCTION FACILITY LOCATION DRAWING

REI H17-21D, H17-28D, H17-30D

SECTION: 17
TOWNSHIP: 3N
RANGE: 65W

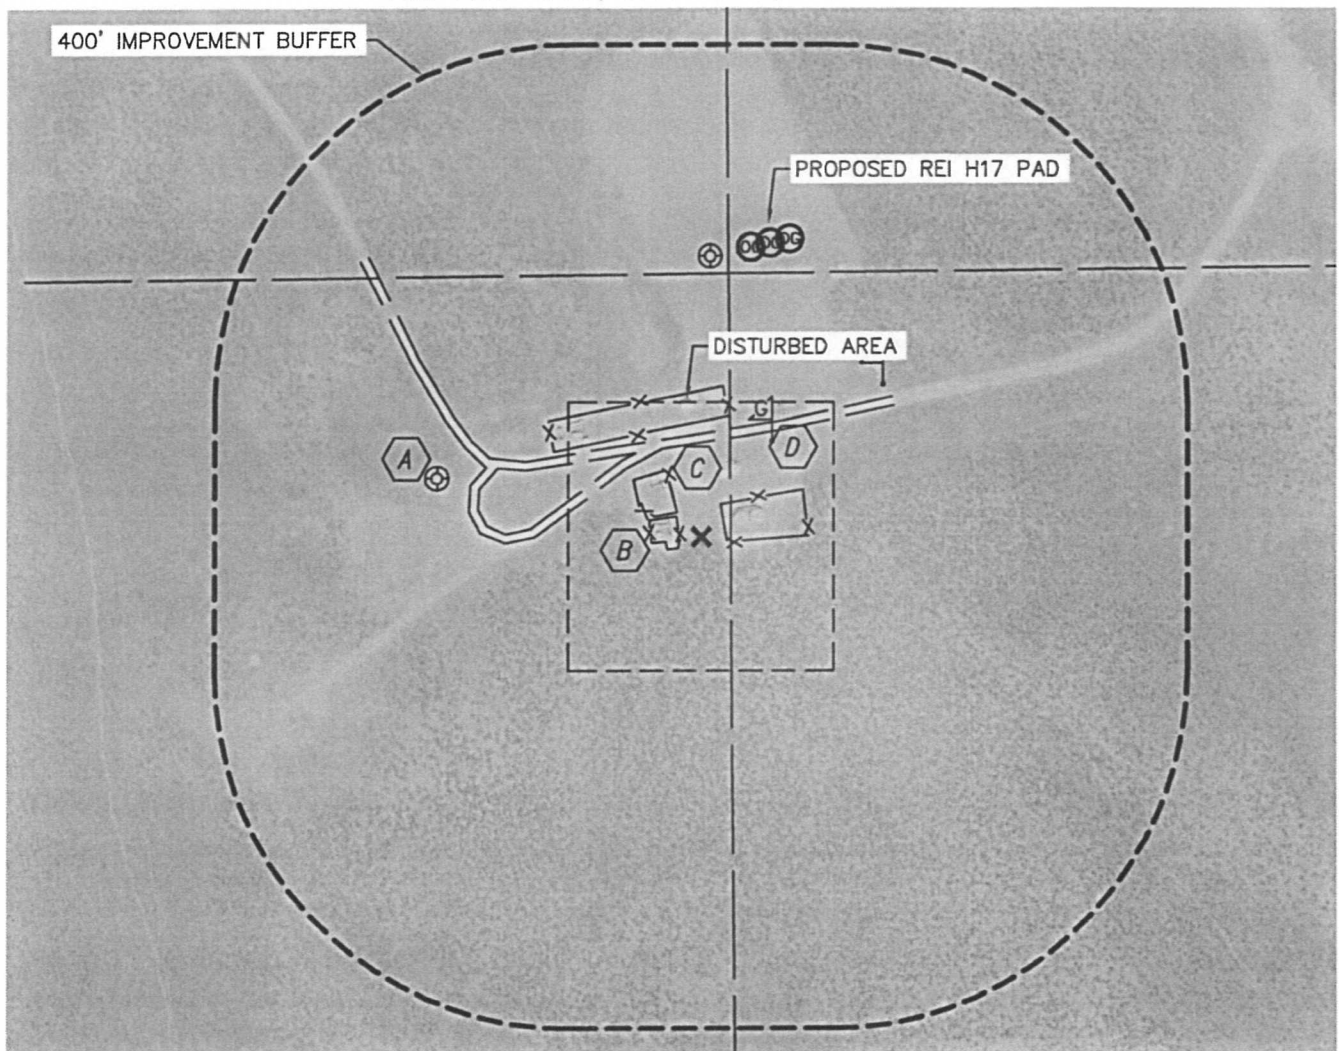

REFERENCE POINT LOCATION:

LATITUDE: 40.22822°N
LONGITUDE: 104.69218°W

ELEV: 4928'
PDOP: 1.5

DATE: 10/10/2011
OPERATOR: BRIAN BRINKMAN

1/41/4: SW1/4NW1/4

FNL: 1610'

FWL: 1298'

DISTANCE TO WELL: 329'

ASSOCIATED NEW WELLS:

REI H17-21D

REI H17-28D

REI H17-30D

ASSOCIATED EXISTING WELLS:

UPRC H17-3J, 4J, 19

REI H17-31D

IMPROVEMENTS:



EX. O&G WELLS 306' NW, 314' N



EX. PRODUCTION EQUIPMENT
23' W, 28' E, 39' NW (NOBLE)
113' NW (KERR MCGEE)



FIELD ROAD 109' N, 113' NW



GAS MARKERS 134' & 267' NE

LEGEND

X - REFERENCE POINT
ALL DISTANCES ARE APPROXIMATE.

NEAREST: BUILDING 2720' NE,
PUBLIC ROAD (CR 39) 1290' W, ABOVE GROUND UTILITY 3898' SW,
RAILROAD 5280'+, PROPERTY LINE 1298' W

