

1625 Broadway  
Suite 2000  
Denver, CO 80202

Tel: 303.228.4000  
Fax: 303.228.4280

www.nobleenergyinc.com



March 6, 2012

Colorado Oil and Gas Conservation Commission  
The Chancery Building  
1120 Lincoln Street, Suite 801  
Denver, CO 80203  
Attn: Mr. Thom Kerr, Acting Director

RE: OSTER C19-69HN  
Niobrara New Drill  
Township 4 North, Range 64 West, 6th P.M.  
Section 19: NW/4NE/4: 264' FNL & 1649' FEL (Surface Location)  
Section 19: NE/4NE/4: 86' FNL & 749' FEL (Beginning of Lateral)  
Section 20: NE/4NE/4: 75' FNL & 535' FEL (Bottom Hole Location)  
Weld County, Colorado

Mr. Kerr:

Noble Energy, Inc. ("NEI") is planning to drill the captioned boundary well in accordance with the provisions of COGCC Rule 318A.e.

NEI's proposed wellbore spacing unit consists of the S/2S/2 of Section 17, SE/4SE/4 of Section 18, NE/4NE/4 of Section 19, and the N/2N/2 of Section 20, T4N, R64W, creating a 400-acre wellbore spacing unit for the Niobrara formation. NEI is the only owner within the proposed wellbore spacing unit, therefore NEI hereby attests that no notice letters are required under COGCC Rule 318A(l).e.(6).

Enclosed are copies of the following documents to assist you in your review and approval of NEI's proposed APD for the captioned well:

- Map & plat illustrating proposed wellbore spacing unit.

Thank you for your attention to the enclosed. NEI respectfully requests that the COGCC review the enclosed information and approve the Application for Permit to Drill the captioned well.

Sincerely,

A handwritten signature in blue ink that reads 'Mari Clark'.

Mari Clark  
Regulatory Analyst II  
Noble Energy Inc.

**OSTER C19-69HN**  
**Noble Energy, Inc.**  
 SE/4SE/4 Section 18, S2/S2 Section 17,  
 NE/4NE/4 Section 19, N/2N/2 Section 20  
 Township 4 North, Range 64 West




Legend

 <p>Proposed 400 acre spacing unit</p>	 <p>Bottom Hole Location</p>
---	---

# WELL LOCATION CERTIFICATE

SECTION: 19  
TOWNSHIP: 4N  
RANGE: 64W


THIS MAP DOES NOT REPRESENT A BOUNDARY SURVEY

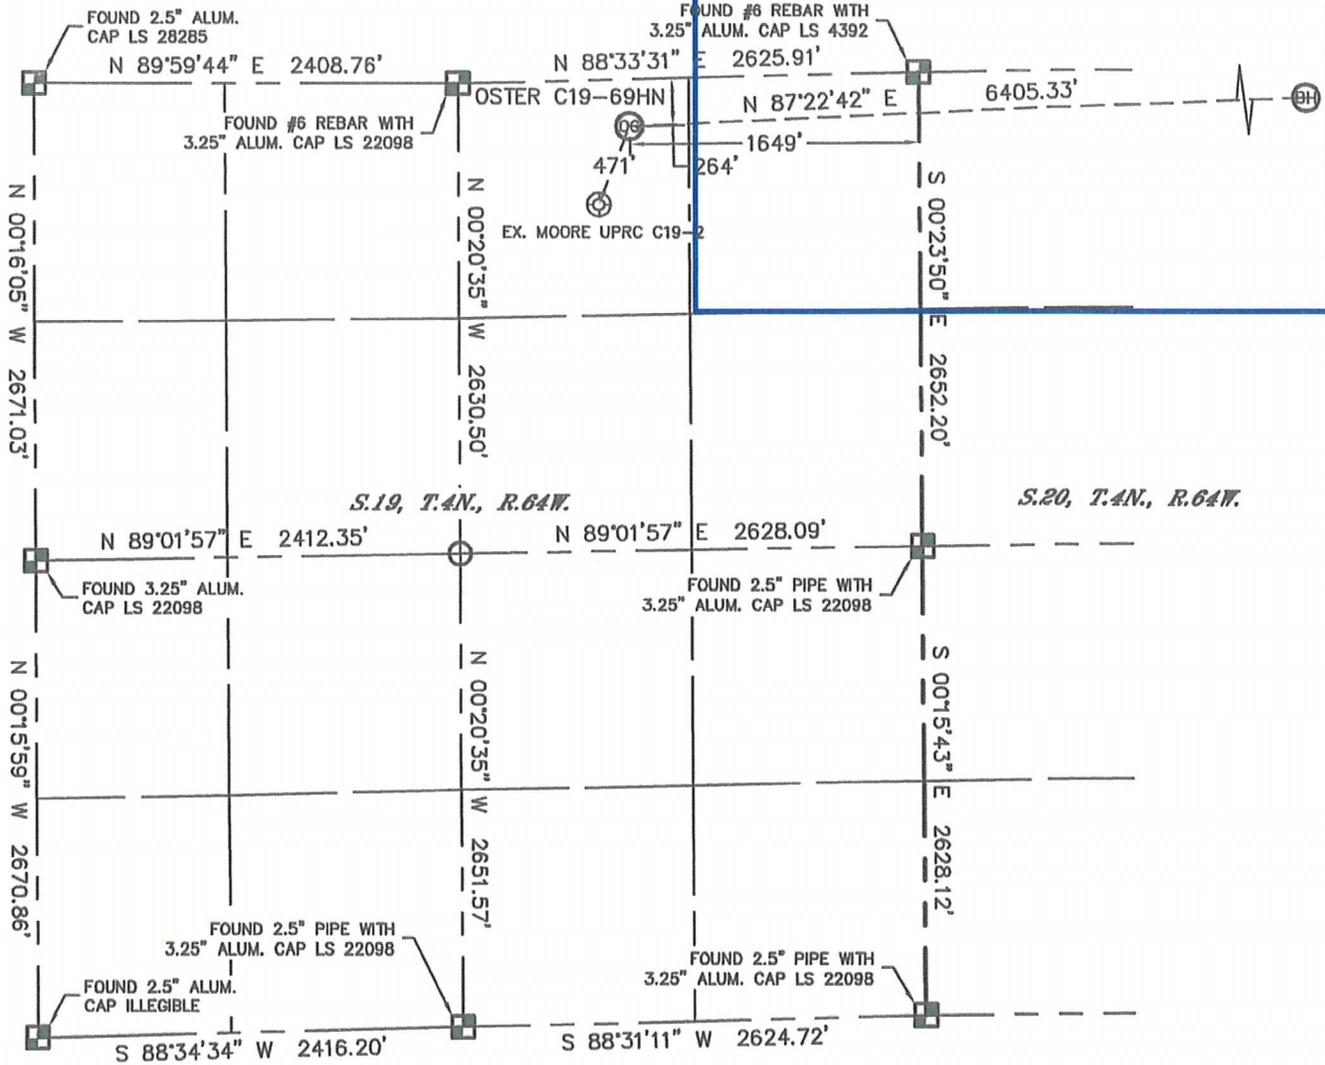

In accordance with a request from Scott Lewis with Noble Energy Inc. Lat40°, Inc. has determined the surface location of the OSTER C19-69HN to be 264' from the NORTH line and 1649' from the EAST line as measured at right angles from the section lines of Section 19, Township 4 North, Range 64 West and the bottom hole to be 75' from the NORTH line and 535' from the EAST line as measured at right angles from the section lines of Section 20, Township 4 North, Range 64 West of the Sixth Principal Meridian, County of Weld, State of Colorado.

I hereby state that this Well Location Certificate was prepared by me, or under my direct supervision, that the fieldwork was completed on 7/28/11, for and on behalf of Noble Energy Inc. That this is not a Land Survey Plat or an Improvement Survey Plat, and that it is not to be relied upon for establishment of fence, building, or other future improvement lines.

SURFACE LOCATION	BOTTOM HOLE
LATITUDE: 40.30435°N	LATITUDE: 40.30497°N
LONGITUDE: 104.59001°W	LONGITUDE: 104.58708°W
PDOP: 1.7	
ELEV: 4807'	
1/4, 1/4: NW1/4NE1/4	
NEAREST PROPERTY LINE: ±236' SW	

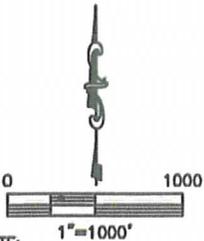

**NOTE:**

- 1) Bearings shown are Grid Bearings of the Colorado State Plane Coordinate System, North Zone, North American Datum 1983/2007. The lineal dimensions as contained herein are based upon the "U.S. Survey Foot."
- 2) Ground elevations are based on an observed GPS elevation (NAVD 1988 DATUM).
- 3) NEAREST EXISTING WELL: MOORE UPRC C19-2, 471'
- 4) IMPROVEMENTS: See LOCATION DRAWING for all visible improvements within 400' of disturbed area.
- 5) SURFACE USE: CROP FIELD
- 6) INSTRUMENT OPERATOR: ADAM KELLY

**NOTE**

According to Colorado law, you must commence any legal action based upon any defect in this W.L.C. within three years after you discover such defect. In no event, may any action based upon any defect in this survey be commenced more than ten years after the date of the certificate shown hereon. (13-80-105 C.R.S.)


**LEGEND**

-  = ALIQUOT MONUMENT AS DESCRIBED
-  = CALCULATED POSITION

(SHEET 1 OF 2)

Brian T. Brinkman—On behalf of Lat40°, Inc.  
Colorado Licensed Professional  
Land Surveyor No. 38175


PROJECT#: 2011189

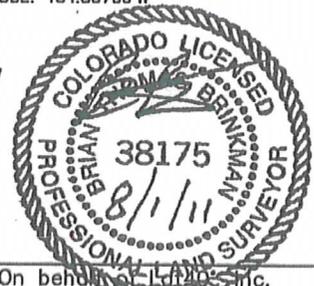

# WELL LOCATION CERTIFICATE

THIS MAP DOES NOT REPRESENT A BOUNDARY SURVEY


SECTION: 19  
TOWNSHIP: 4N  
RANGE: 64W

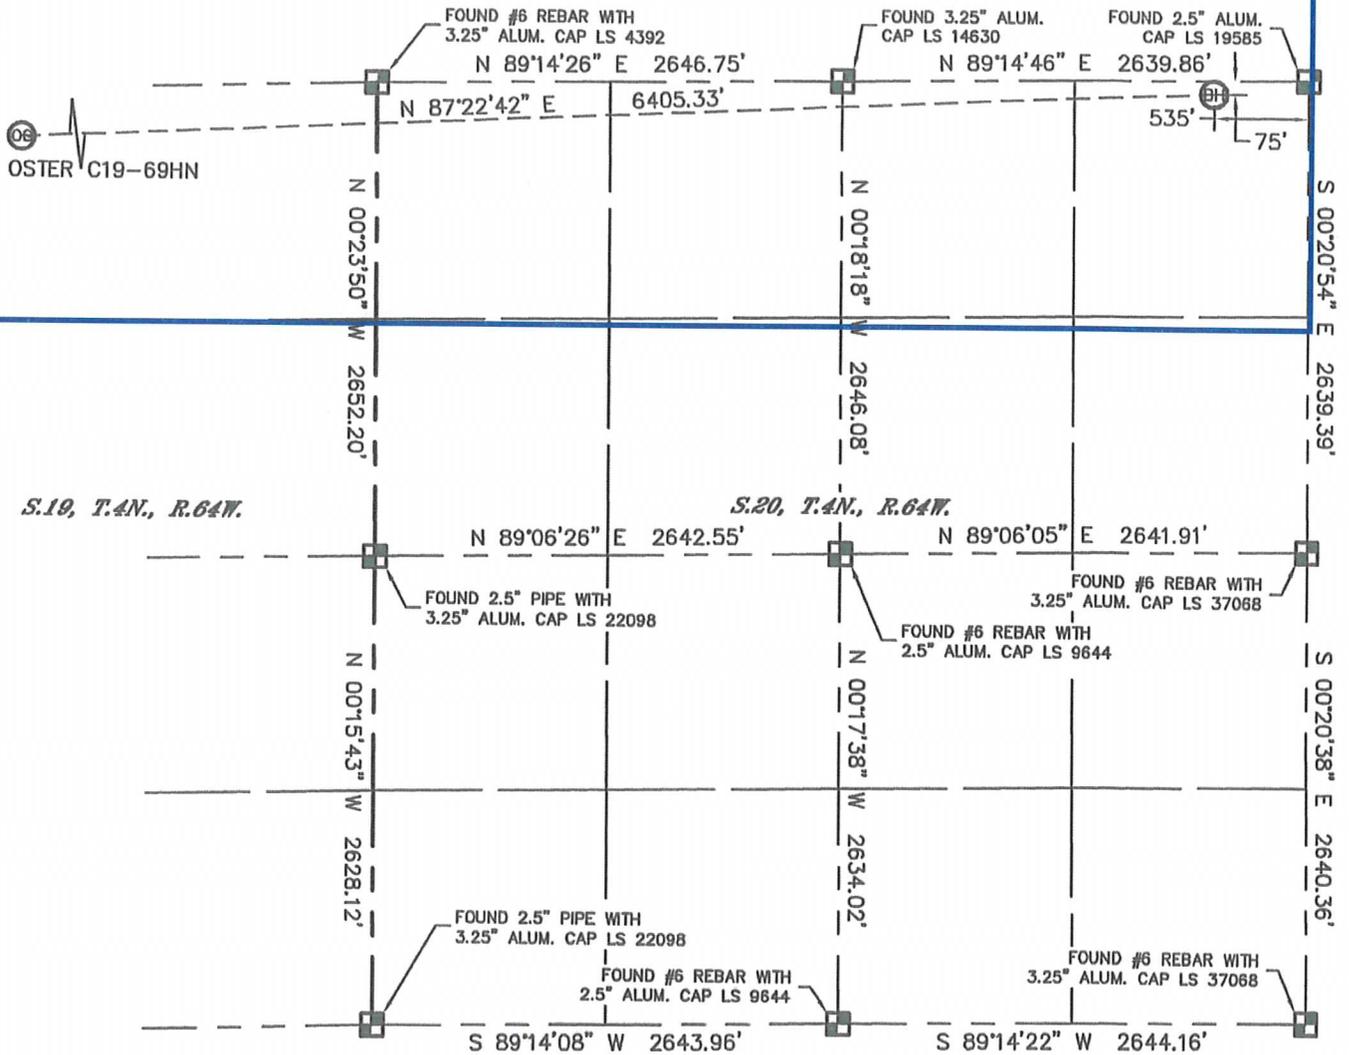

OSTER C19-69HN

*S.19, T.4N, R.64W.*

*S.20, T.4N, R.64W.*

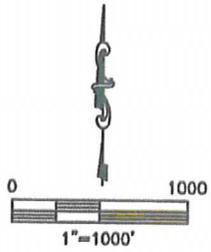

**NOTE**  
According to Colorado law, you must commence any legal action based upon any defect in this W.L.C. within three years after you discover such defect. In no event, may any action based upon any defect in this survey be commenced more than ten years after the date of the certificate shown hereon. (13-80-105 C.R.S.)

**LEGEND**  
 = ALIQUOT MONUMENT AS DESCRIBED  
 = CALCULATED POSITION

*(SHEET 2 OF 2)*  
 Brian T. Brinkman—On behalf of Lat40°, Inc.  
 Colorado Licensed Professional  
 Land Surveyor No. 38175 PROJECT#: 2011189