


# WELL LOCATION CERTIFICATE

THIS MAP DOES NOT REPRESENT A BOUNDARY SURVEY

SECTION: 25  
TOWNSHIP: 3N  
RANGE: 65W

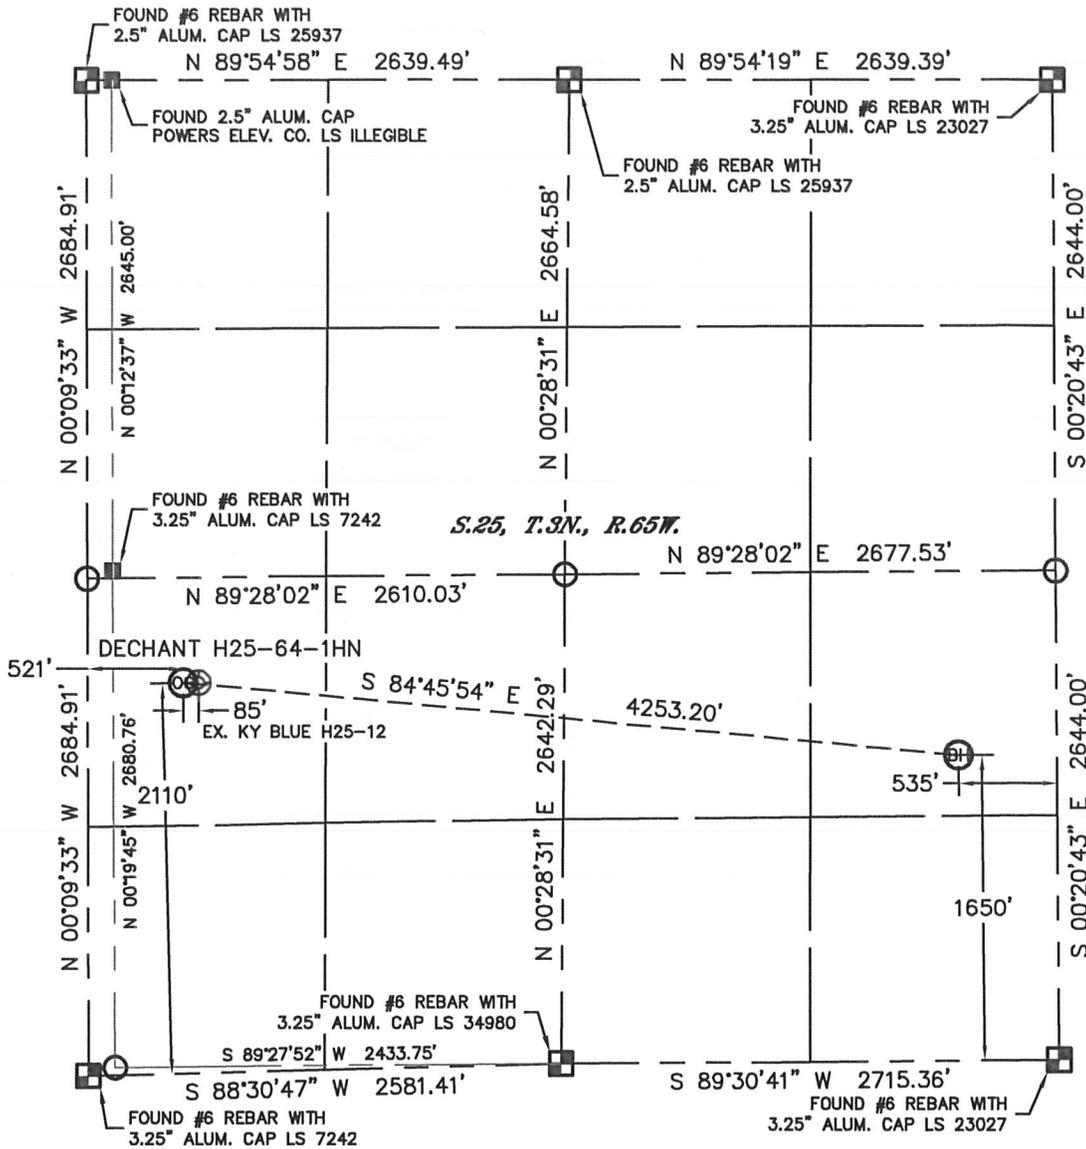

In accordance with a request from Mike Rodine with Noble Energy Inc. Lat40°, Inc. has determined the surface location of the DECHANT H25-64-1HN to be 2110' from the SOUTH line and 521' from the WEST line and the bottom hole to be 1650' from the SOUTH line and 535' from the EAST line as measured at right angles from the section lines of Section 25, Township 3 North, Range 65 West of the Sixth Principal Meridian, County of Weld, State of Colorado.

I hereby state that this Well Location Certificate was prepared by me, or under my direct supervision, that the fieldwork was completed on 10/27/11, for and on behalf of Noble Energy Inc. That this is not a Land Survey Plat or an Improvement Survey Plat, and that it is not to be relied upon for establishment of fence, building, or other future Improvement lines.

**NOTE:**


- 1) Bearings shown are Grid Bearings of the Colorado State Plane Coordinate System, North Zone, North American Datum 1983/2007. The lineal dimensions as contained herein are based upon the "U.S. Survey Foot."
- 2) Ground elevations are based on an observed GPS elevation (NAVD 1988 DATUM).
- 3) NEAREST EXISTING WELL: KY BLUE H25-12, 85'
- 4) IMPROVEMENTS: See LOCATION DRAWING for all visible improvements within 400' of disturbed area.
- 5) SURFACE USE: RANGELAND / EX. WELL SITE
- 6) INSTRUMENT OPERATOR: WYATT HALL

**SURFACE LOCATION**  
 LATITUDE: 40.19459°N  
 LONGITUDE: 104.61985°W  
 PDOP: 1.4  
 ELEV: 4838'  
 1/4, 1/4: NW1/4SW1/4  
 NEAREST PROPERTY LINE: 380' W

**BOTTOM HOLE**  
 LATITUDE: 40.19341°N  
 LONGITUDE: 104.60471°W



**NOTE**  
 According to Colorado law, you must commence any legal action based upon any defect in this W.L.C. within three years after you discover such defect. In no event, may any action based upon any defect in this survey be commenced more than ten years after the date of the certificate shown hereon. (13-80-105 C.R.S.)

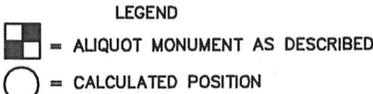


Brian T. Brinkman—On behalf of Lat40°, Inc.  
 Colorado Licensed Professional  
 Land Surveyor No. 38175 PROJECT#: 2010143

# SITE SKETCH

## DECHANT H25-64-1HN

SECTION: 25  
TOWNSHIP: 3N  
RANGE: 65W

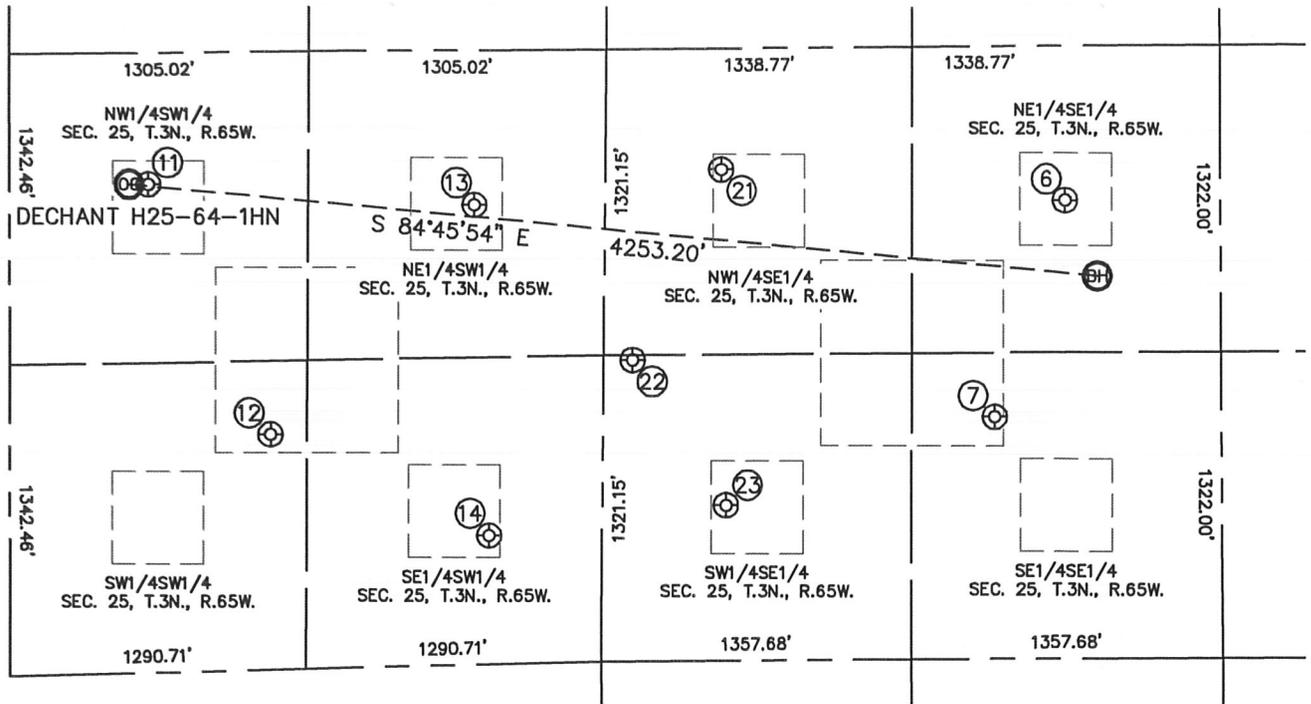

⑥

KY BLUE H 25-9  
NE1/4SE1/4  
1977' FSL  
673' FEL  
LAT-40.19431°N  
LONG-104.60520°W  
PDOP: 0.9  
ELEV: 4797'

⑦

KY BLUE H 25-4J  
SE1/4SE1/4  
1046' FSL  
986' FEL  
LAT-40.19175°N  
LONG-104.60633°W  
PDOP: 2.9  
ELEV: 4800'

⑪

KY BLUE H25-12  
NW1/4SW1/4  
2107' FSL  
606' FWL  
LAT-40.19459°N  
LONG-104.61955°W  
PDOP: 1.9  
ELEV: 4836'

⑫

VON FELDT 1-25B  
SW1/4SW1/4  
1015' FSL  
1137' FWL  
LAT-40.19161°N  
LONG-104.61767°W  
PDOP: 1.3  
ELEV: 4825'

⑬

KY BLUE H25-11  
NE1/4SW1/4  
1983' FSL  
2031' FWL  
LAT-40.19431°N  
LONG-104.61445°W  
PDOP: 1.3  
ELEV: 4819'

⑭

KY BLUE H25-14  
SE1/4SW1/4  
556' FSL  
2094' FWL  
LAT-40.19039°N  
LONG-104.61426°W  
PDOP: 1.3  
ELEV: 4813'

⑰

KY BLUE H25-10  
NW1/4SE1/4  
2120' FSL  
2178' FEL  
LAT-40.19471°N  
LONG-104.61058°W  
PDOP: 2.0  
ELEV: 4805'

⑱

KY H25-24  
SW1/4SE1/4  
1300' FSL  
2569' FEL  
LAT-40.19248°N  
LONG-104.61199°W  
PDOP: 2.0  
ELEV: 4807'

⑳

KY BLUE H25-15  
SW1/4SE1/4  
671' FSL  
2166' FEL  
LAT-40.19073°N  
LONG-104.61055°W  
PDOP: 2.1  
ELEV: 4805'

