


Well Name: MCKENNEY 13-22

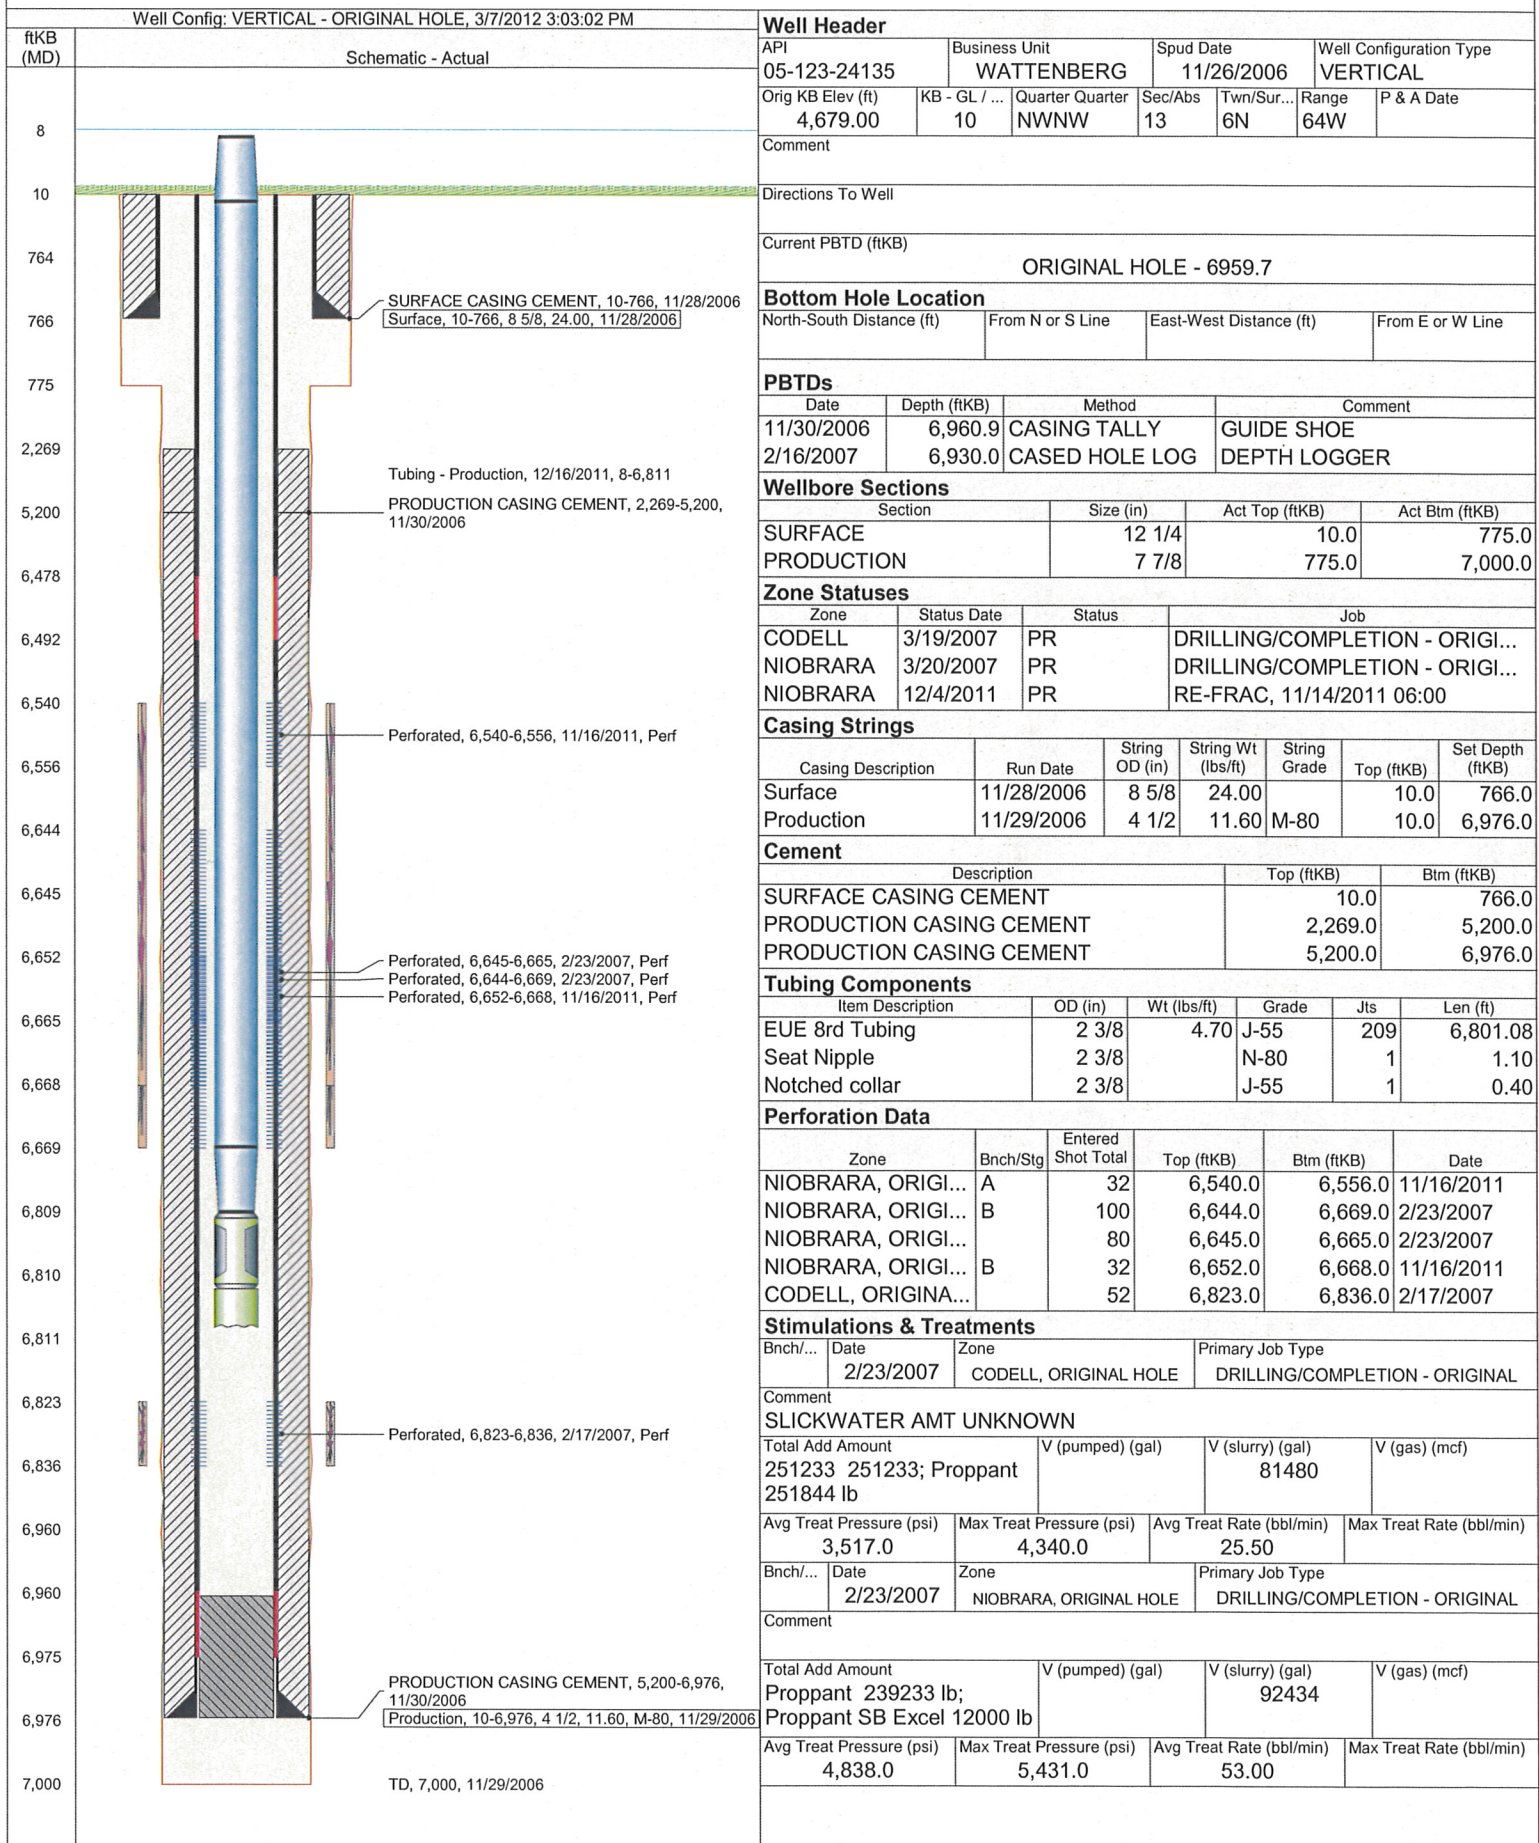

Well Name: MCKENNEY 13-22

Well Config: VERTICAL - ORIGINAL HOLE, 3/7/2012 3:03:02 PM

Stimulations & Treatments

Brch/...	Date	Zone	Primary Job Type	
A/B	12/2/2011	NIOBRARA, ORIGINAL HOLE	RE-FRAC	
Comment				
(NIO REFRAC): JOB WENT AS PLANNED 5 MIN SIP 3156				
Total Add Amount		V (pumped) (gal)	V (slurry) (gal)	V (gas) (mcf).
Proppant Ottawa		149081	160410	
249659.904 lb				
Avg Treat Pressure (psi)		Max Treat Pressure (psi)	Avg Treat Rate (bbl/min)	Max Treat Rate (bbl/min)
4,103.0		4,464.0	44.00	46.60

Other In Hole

Run Date	Description	OD (in)	Top (ftKB)	Btm (ftKB)

Logs

Date	Type	Top (ftKB)	Btm (ftKB)
11/30/2006	COMPENSATED DENSITY	3,000.0	6,979.0
11/30/2006	INDUCTION	766.0	6,999.0
2/16/2007	ACOUSTIC	2,150.0	6,930.0

