

TECHNICAL INFORMATION PAGE



FOR OGCC USE ONLY
RECEIVED
MAR 08 2012
OGCC/Rifle Office

- 1. OGCC Operator Number: 10071 API Number: 05-045-20735
- 2. Name of Operator: Bill Barrett Corporation OGCC Facility ID # _____
- 3. Well/Facility Name: GGU Kaufman Well/Facility Number: 11A-30-691
- 4. Location (QtrQtr, Sec, Twp, Rng, Meridian): SWNW, Sec. 30, T6S, R91W 6th PM

This form is to be completed whenever a Sundry Notice is submitted requiring detailed report of work to be performed or completed. This form shall be transmitted within 30 days of work completed as a "subsequent" report and must accompany Form 4, page 1.

5. DESCRIBE PROPOSED OR COMPLETED OPERATIONS

The referenced well has been successfully cemented according to the approved plan and a summary of the Bradenhead monitoring.
Bill Barrett Corporation requests approval to commence completion operations.

Attachments:

CBL 3054' TOC JK 3/08/12
AS-BUILT WELLBORE SCHEMATIC
TEMPERATURE SURVEY
BRADENHEAD PRESSURE SUMMARY

RFC

MAR 08 2012

COGCC/Rifle Office

BILL BARRETT CORPORATION
Bradenhead Pressure Summary



Well: GGU Kaufman 11A-30-691
Pad: Kaufman 3
API No: 05-04-20735
Document No: 400148216

Bradenhead Pressure Report Following Primary Cement Job

Date Cemented: 1/22/2012
Plug Bumped: 1/22/2012 @ 13:30
Casing Slips Set: 1/22/2012 @ 15:00
WOC Time: 5+hrs
Temp. Log Run: 1/22/2012 2 18:00

Bradenhead Pressures


6 hrs:	0	psig
12 hrs:	0	psig
24 hrs:	0	psig
48 hrs:	0	psig
72 hrs:	0	psig

Comments:

Top of cement based on Temperature log: ~3858' MD; Estimated Top of Gas: 4670' MD.

RECEIVED
MAR 08 2012
COGCC/Rifle Office

GGU Kaufman
11A-30-691
T6S R01W S30
05045207350000

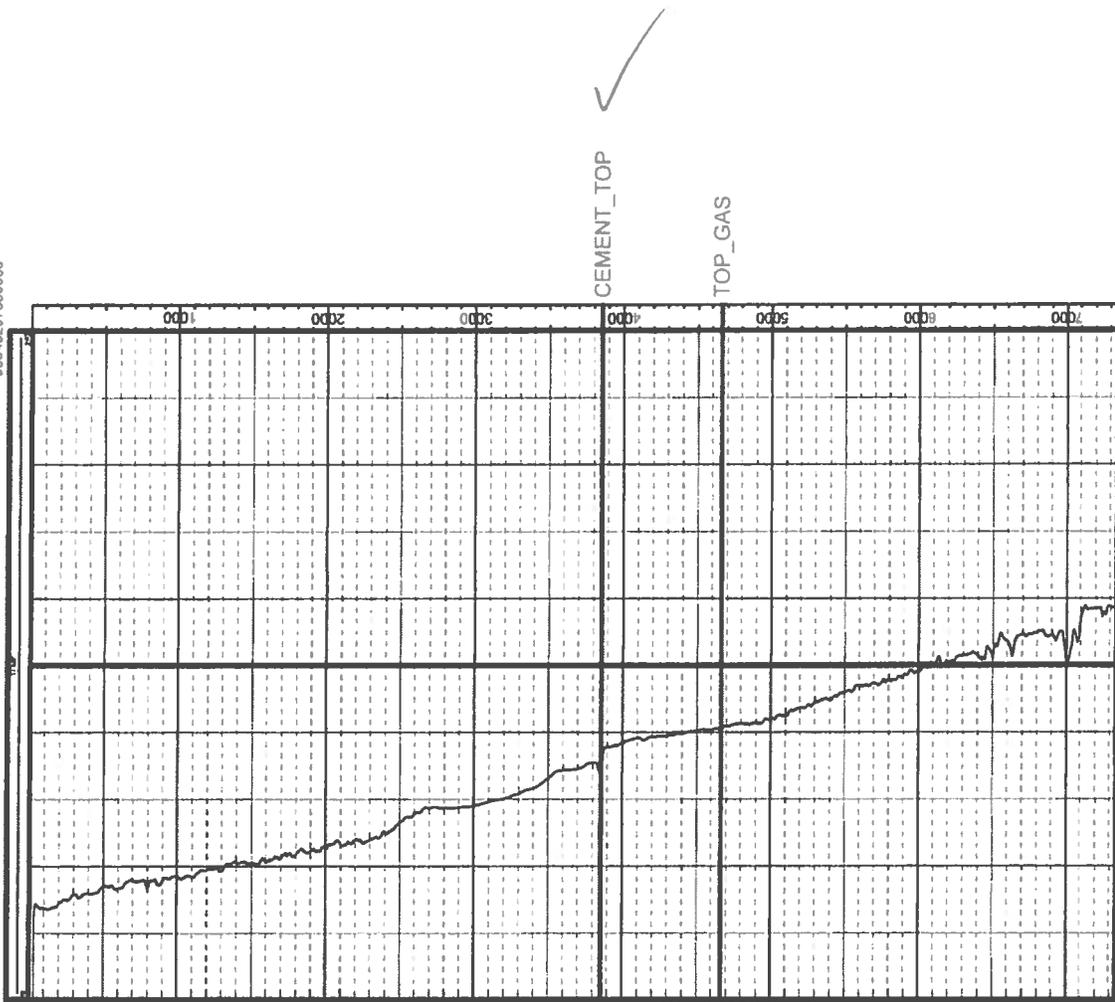

~3875'
JK 3/8/12
COGCC