



02121426



## SUNDRY NOTICE

Submit original plus one copy. This form is to be used for general, technical and environmental sundry information. For proposed or completed operations, describe in full on Technical Information Page (Page 2 of this form.) Identify well or other facility by API Number or by OGCC Facility ID. Operator shall send an informational copy of all sundry notices for wells located in High Density Areas to the Local Government Designee (Rule 603b.)

RECEIVED

MAR 08 2012

Complete the Affidavit  
Checklist

OP OGCC

1. OGCC Operator Number: 100185  
2. Name of Operator: Encana Oil & Gas (USA) Inc.  
3. Address: 370 17th Street Suite 1700  
City: Denver State: CO Zip 80202  
4. Contact Name: Bonnie Lamond  
Phone: 720.876.5156  
Fax: 720.876.6177  
5. API Number 05-045-20777-0000 OGCC Facility ID Number 335409  
6. Well/Facility Name: Encana Fee 7. Well/Facility Number 19-10B (K19CNE)  
8. Location (Qtr/Qtr, Sec, Twp, Rng, Meridian): Lot 3 Sec 19, T6S, R92W 6 P.M.  
9. County: Garfield 10. Field Name: Mamm Creek  
11. Federal, Indian or State Lease Number:

Survey Plat  
Directional Survey  
Surface Eqpm Diagram  
Technical Info Page X  
Other

## General Notice

☐ CHANGE OF LOCATION: Attach New Survey Plat (a change of surface qtr/qtr is substantive and requires a new permit)

	FNU/FSL	FEL/FWL
Change of Surface Footage from Exterior Section Lines:		
Change of Surface Footage to Exterior Section Lines:		
Change of Bottomhole Footage from Exterior Section Lines:		
Change of Bottomhole Footage to Exterior Section Lines:		

Bottomhole location Qtr/Qtr, Sec, Twp, Rng, Mer \_\_\_\_\_  
Latitude \_\_\_\_\_ Distance to nearest property line \_\_\_\_\_ Distance to nearest bldg, public rd, utility or RR \_\_\_\_\_  
Longitude \_\_\_\_\_ Distance to nearest lease line \_\_\_\_\_ Is location in a High Density Area (rule 603b)? Yes/No \_\_\_\_\_  
Ground Elevation \_\_\_\_\_ Distance to nearest well same formation \_\_\_\_\_ Surface owner consultation date: \_\_\_\_\_

## GPS DATA:

Date of Measurement \_\_\_\_\_ PDOP Reading \_\_\_\_\_ Instrument Operator's Name \_\_\_\_\_

☐ CHANGE SPACING UNIT

Formation	Formation Code	Spacing order number	Unit Acreage	Unit configuration

☐ Remove from surface bond  
Signed surface use agreement attached

☐ CHANGE OF OPERATOR (prior to drilling):Effective Date: \_\_\_\_\_  
Plugging Bond: ☐ Blanket ☐ Individual☐ CHANGE WELL NAMEFrom: \_\_\_\_\_ NUMBER \_\_\_\_\_  
To: \_\_\_\_\_  
Effective Date: \_\_\_\_\_☐ ABANDONED LOCATION:Was location ever built? ☐ Yes ☐ No  
Is site ready for inspection? ☐ Yes ☐ No  
Date Ready for Inspection: \_\_\_\_\_☐ NOTICE OF CONTINUED SHUT IN STATUSDate well shut in or temporarily abandoned: \_\_\_\_\_  
Has Production Equipment been removed from site? ☐ Yes ☐ No  
MIT required if shut in longer than two years. Date of last MIT: \_\_\_\_\_☐ SPUD DATE: \_\_\_\_\_☐ REQUEST FOR CONFIDENTIAL STATUS (5 mos from data casing set)☐ SUBSEQUENT REPORT OF STAGE, SQUEEZE OR REMEDIAL CEMENT WORK

\*submit cbl and cement job summaries

Method used	Cementing tool setting/perf depth	Cement volume	Cement top	Cement bottom	Date

☐ RECLAMATION: Attach technical page describing final reclamation procedures per Rule 1004.Final reclamation will commence on approximately \_\_\_\_\_ ☐ Final reclamation is completed and site is ready for inspection.

## Technical Engineering/Environmental Notice

☒ Notice of Intent

Approximate Start Date: As soon as approved

☐ Report of Work Done

Date Work Completed: \_\_\_\_\_

Details of work must be described in full on Technical Information Page (Page 2 must be submitted.)

<input type="checkbox"/> Intent to Recomplete (submit form 2)	<input type="checkbox"/> Request to Vent or Flare	<input type="checkbox"/> E&P Waste Disposal
<input type="checkbox"/> Change Drilling Plans	<input type="checkbox"/> Repair Well	<input type="checkbox"/> Beneficial Reuse of E&P Waste
<input type="checkbox"/> Gross Interval Changed?	<input type="checkbox"/> Rule 502 variance requested	<input type="checkbox"/> Status Update/Change of Remediation Plans
<input type="checkbox"/> Casing/Cementing Program Change	<input checked="" type="checkbox"/> Other: Request to Complete Mamm Creek Well	for Spills and Releases

I hereby certify that the statements made in this form are, to the best of my knowledge, true, correct and complete.

Signed: \_\_\_\_\_

Date: 1/29/11

Email: bonnie.lamond@encana.com

Print Name: Bonnie Lamond

Title: Permitting Technician

COGCC Approved: \_\_\_\_\_

Title: NWA E

Date: 3/9/12

CONDITIONS OF APPROVAL, IF ANY:

TECHNICAL INFORMATION PAGE



FOR OGCC USE ONLY

RECEIVED

MAR 08 2012

COGCC/Rifle Office

1. OGCC Operator Number: 100185 API Number: 05- 045-20777-0000
2. Name of Operator: Encana Oil & Gas (USA) Inc. OGCC Facility ID # 335409
3. Well/Facility Name: Encana Fee Well/Facility Number: 19-10B (K19CNE)
4. Location (QtrQtr, Sec, Twp, Rng, Meridian): Lot 3 Sec 19, T6S, R92W 6 P.M.

This form is to be completed whenever a Sundry Notice is submitted requiring detailed report of work to be performed or completed. This form shall be transmitted within 30 days of work completed as a "subsequent" report and must accompany Form 4, page 1.

5.

DESCRIBE PROPOSED OR COMPLETED OPERATIONS

The above referenced well has been successfully cemented according to the approved plan and summary of bradenhead monitoring completed.

Encana Oil & Gas (USA) Inc. requests approval to commence completions.

**Attachments:**

Wellbore Diagram with FIT and Final Mud Weight  
Bradenhead Pressure Report  
CBL Log with Temperature Survey

**Engineer Contact Information:**

Ryan McGilvery  
Completion Engineer  
370 17th. Street, Suite 1700  
Denver, CO 80202  
720-876-3681

or

Craig Miley  
Completion Engineer  
370 17th. Street, Suite 1700  
Denver, CO 80202  
720-876-5396

**RECEIVED**

MAR 08 2012

COGCC/Rifle Office

Well:	Encana Fee 19-10B
Pad:	K19CNE
API No:	05-045-20777
Permit No:	400161931

**Bradenhead Pressure Report Following Primary Cement Job**

Date Cemented:	01/30/2012
Plug Bumped:	Yes

Annular Fluid Level After Job (Static or Falling?):	Static	
If falling, barrels of mud added until stabilized:		barrels

WOC Time:	717
Bond Log Run:	03/01/2012

Casing Slips Set:	01/30/2012
-------------------	------------

**Bradenhead Pressures**

6 hrs:	0	psig
12 hrs:	0	psig
24 hrs:	0	psig
48 hrs:	0	psig
72 hrs:	0	psig

**Comments**

**RECEIVED**

**MAR 08 2012**

**COGCC/Rifle Office**

**Surface**  
**Fee**

**Minerals**  
**Fee**

**Name**  
**Encana Fee 19-10B (K19CNE)**

**Permit Estimated  
Formation Tops  
(MD / TVD)**

**Casing &  
Hole size**

**Actual  
Conditions  
(MD / TVD)**

**16" Conductor @ 40'**

Cement to surface with 5 yds redi-mix

<b>Wasatch</b>	<b>Surface / Surface</b>
----------------	--------------------------

**12-1/4" Surface Hole**

<b>Surface Casing</b>	<b>1289 / 1248</b>
-----------------------	--------------------

**9-5/8" 36# J/K55**

Cement to surface with:

Lead: 270 sxs 12.5 Glass G 2.11 ft<sup>3</sup>/sk

Tail: 134 sx, 15.8, Class G 1.17 ft<sup>3</sup>/sk

Total: 404 sx

(volume includes 80% excess)

**7-7/8" Production Hole**

<b>Atwell Gulch</b>	<b>1541 / 1484</b>
---------------------	--------------------

<b>Mesa Verde</b>	<b>3920 / 3708</b>
-------------------	--------------------

**TOC requirement 500ft above TOG**

<b>Williams Fork</b>	<b>4364 / 4376</b>
----------------------	--------------------

<b>Top of Gas</b>	<b>5741 / 5422</b>
-------------------	--------------------

<b>Coal Ridge</b>	<b>6868 / 6546</b>
-------------------	--------------------

<b>Permit TD</b>	<b>8594 / 8272</b>
------------------	--------------------

<b>Production casing</b>	<b>8294 / 7972</b>
--------------------------	--------------------

**4-1/2 11.6# N80**

Cement with:

Lead: 83 sx, 12 TXI, 1.79 ft<sup>3</sup>/sk

Tail: 529 sx, 13 TXI, 1.43 ft<sup>3</sup>/sk

Total: 611 sx

(volume includes 30% excess)

**16" Conductor @ 40'**

Cement to surface with 5 yds redi-mix

<b>Wasatch</b>	<b>Surface / Surface</b>
----------------	--------------------------

**12-1/4" Surface Hole**

<b>Surface Casing</b>	<b># 1344 / 1298</b>
-----------------------	----------------------

**9-5/8", 36# J55**

Cemented to surface with

Lead: 269 sxs, 12.5 ppg Glass G, 2.11 ft<sup>3</sup>/sk

Tail: 150 sxs, 15.8 ppg Class G, 1.17 ft<sup>3</sup>/sk

Total: 419 sxs

**7-7/8" Production Hole**

<b>Mesa Verde</b>	<b>3978 / 3752</b>
-------------------	--------------------

<b>Williams Fork</b>	<b>4574 / 4308</b>
----------------------	--------------------

**TOC from CBL 2870' MD-RKB**

<b>Top of Gas</b>	<b>5936 / 5616</b>
-------------------	--------------------

<b>Coal Ridge</b>	<b>6942 / 6621</b>
-------------------	--------------------

<b>Rollins</b>	<b>7656 / 7335</b>
----------------	--------------------

<b>Actual TD</b>	<b>8340 / 8018</b>
------------------	--------------------

<b>Production casing</b>	<b>8305 / 7983</b>
--------------------------	--------------------

**4-1/2", 11.6# S80**

Cemented with:


Tail: 1430 sx, 13.5 ppg TXI, 1.26 ft<sup>3</sup>/sk

045-20777

RECEIVED

MAR 08 2012

COGCC/Rifle Office

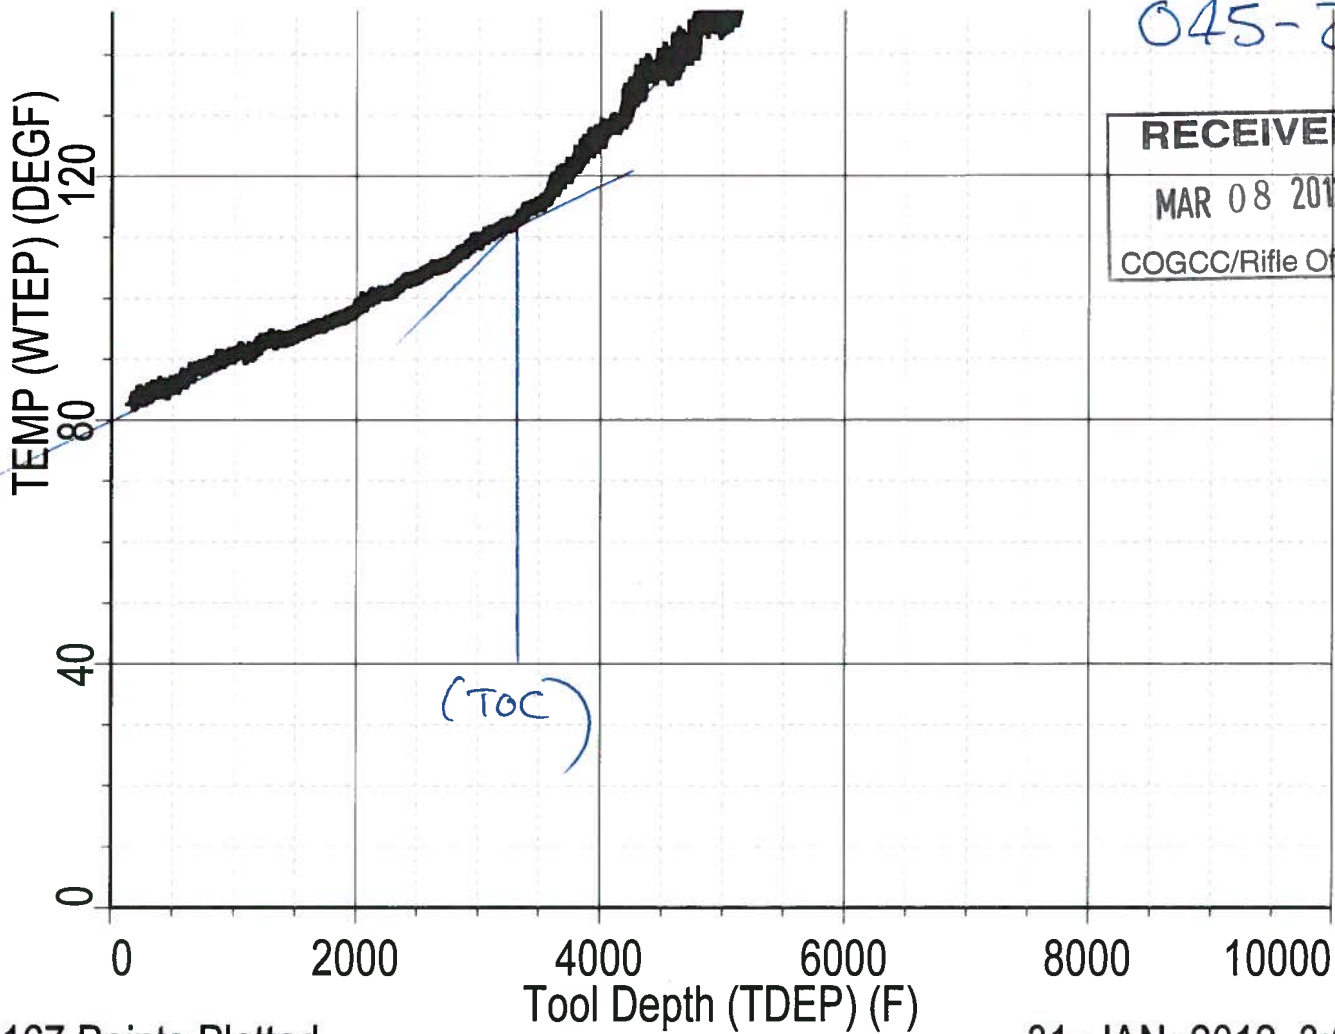

16167 Points Plotted

31-JAN-2012 3:05

Schlumberger

COEFFICIENTS


MAXIS Field Log

Client: ENCANA OIL & GAS (USA) INC.  
 Field: MAMM CREEK  
 Well: ENCANA FEE 19-10B (K19CNE)  
 Run date: 31-Jan-2012

Tool: PSP  
 Sub Type: PBMS  
 Sensor: GR

PBMS Gamma Ray  
 Sonde Serial NB  
 Sensor Serial NB  
 Calib Date ddmmyy  
 Matrix Size  
 Coeff CRC  
 GR HV Rt

RESISTORS FOR GR SENSOR N.34384, TOOL HBMS-BA2880. SENSOR S/N:  
 34384  
 160206  
 12  
 D8B5

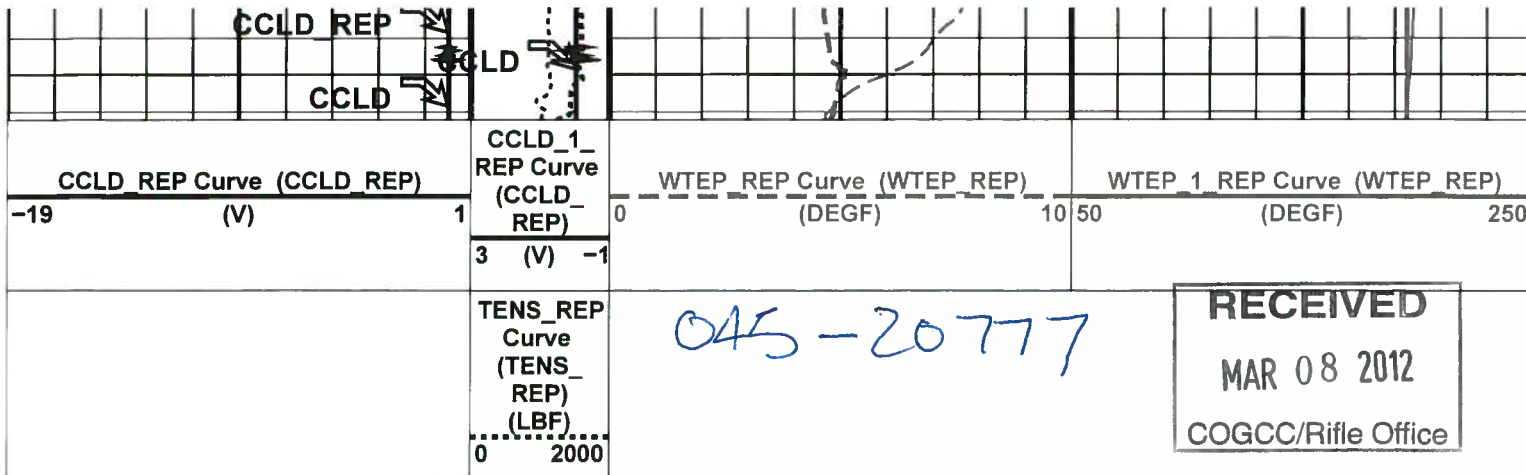

Parameters			
DLIS Name	Description	Value	
System and Miscellaneous			
DO	Depth Offset for Playback	0.0	FT
DORL	Depth Offset for Repeat Analysis	0.0	FT
PP	Playback Processing	NORMAL	
Format: TEMPERATURE_S2_REP		Vertical Scale: 2" per 100'	
		Graphics File Created: 31-Jan-2012 03:01	

OP System Version: 19C0-187						
HBMS-B	19C0-187					
Input DLIS Files						
DEFAULT	Flip_HBMS_004LUP		PRODUCER	31-Jan-2012 02:55	8262.5 FT	179.5 FT
DEFAULT	HBMS_003LUP	FN:2	PRODUCER	31-Jan-2012 02:44	8262.0 FT	7715.5 FT
Output DLIS Files						
DEFAULT	HBMS_006PUP	FN:4	PRODUCER	31-Jan-2012 03:01		

# TEMPERATURE PLOT

MAXIS Field Log

Index: 8262.5 - 179.5 FT

