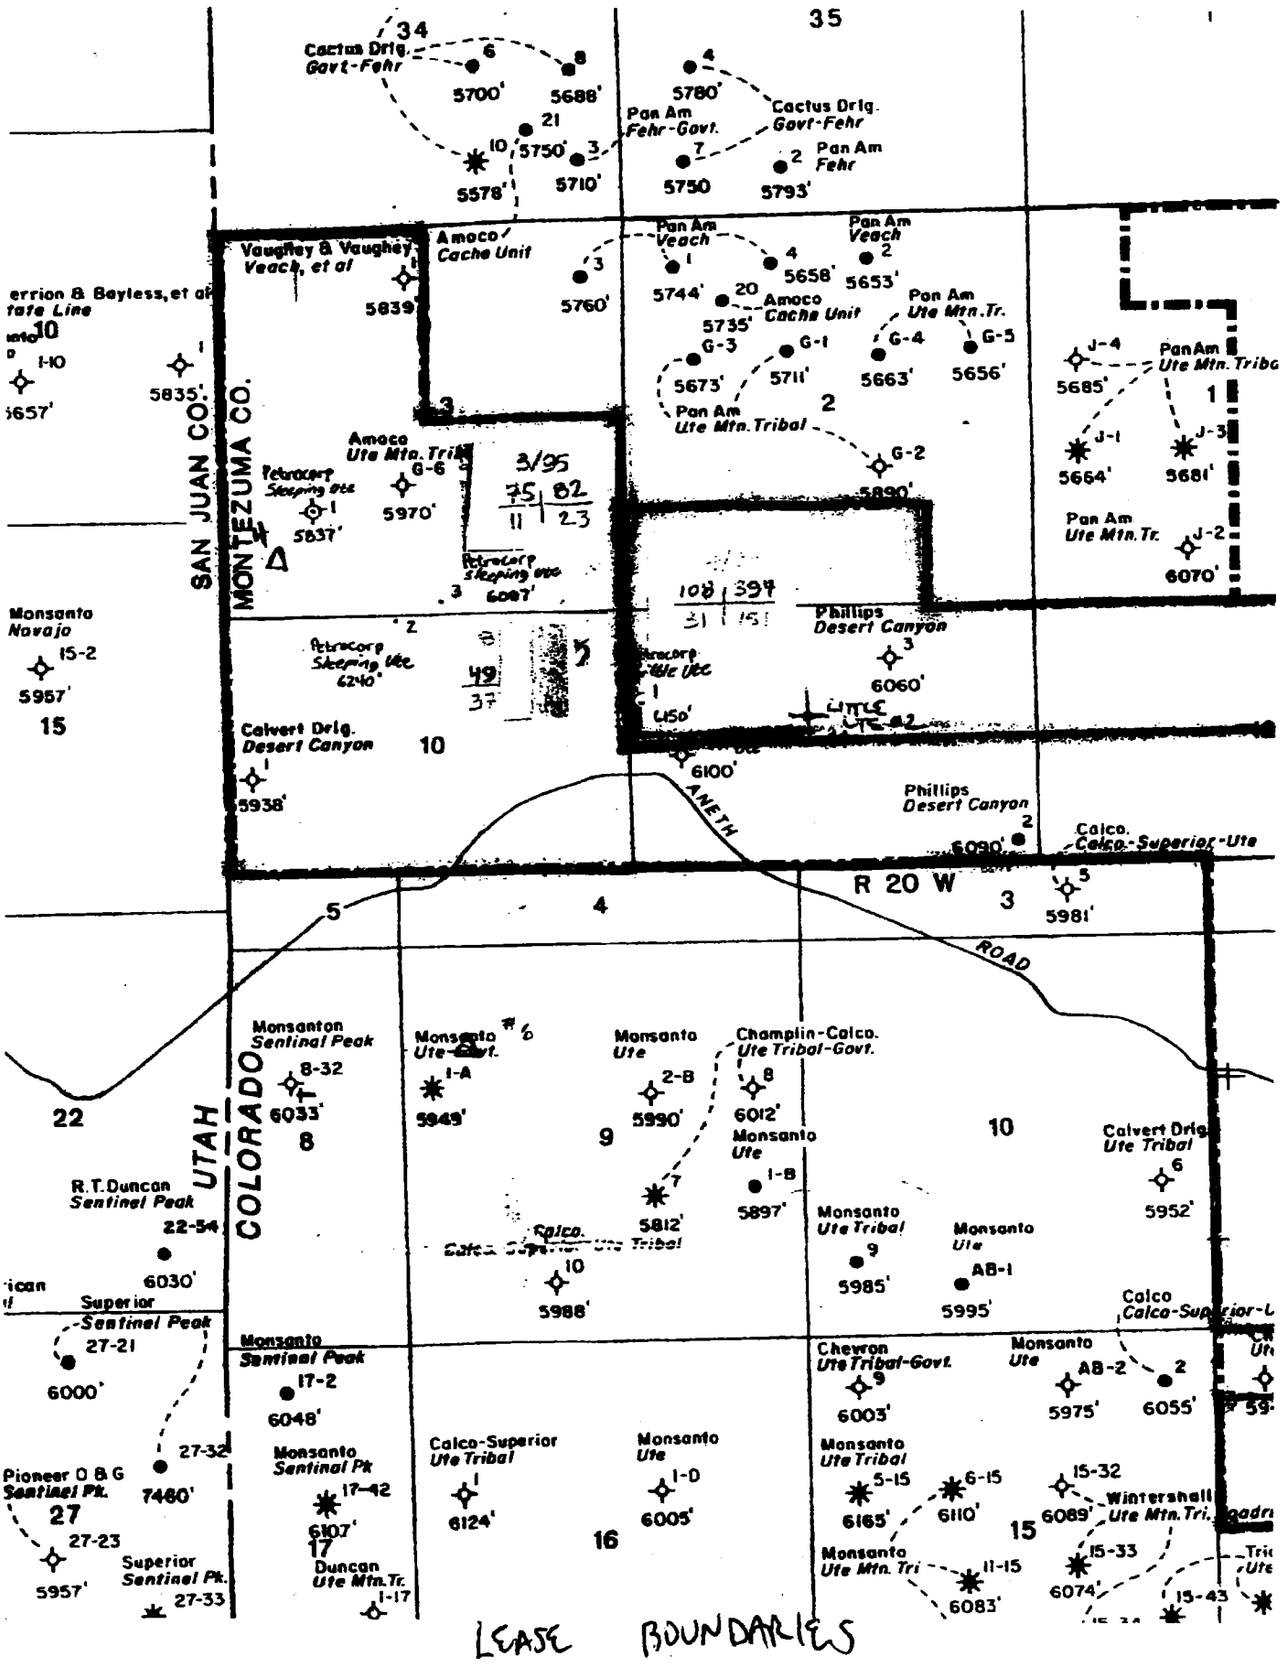

LEASE BOUNDARIES