


7000 File

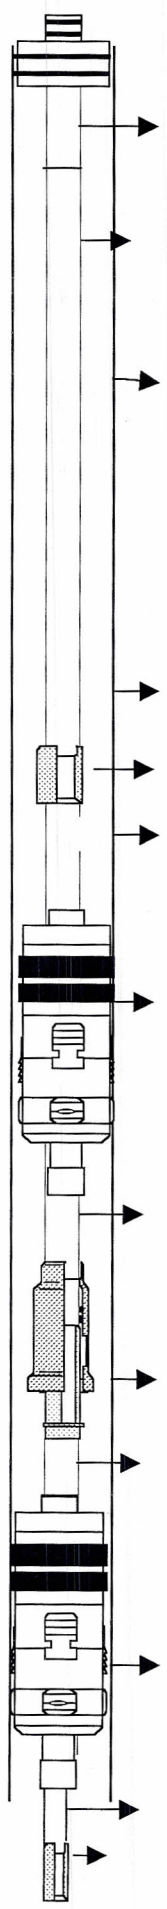

COMPANY:		CHEVRON USA INC.		CASING	LINER	TUBING	TAILPIPE
WELL NUMBER:		U.P.48-29	SIZE	5 1/2'	5"	2 3/8"	2 3/8"
FIELD/LEASE:		RWSU	WEIGHT	17#	18#		
COUNTY:		RIO BLANCO	GRADE	J-55 L-80	L-80		FGW TK-15
STATE:		COLORADO	THREAD				
DATE:		8-Mar-12	DEPTH	0 4957	4957 6444		5765.6

ITEM	DESCRIPTION	O.D.	I.D.	LENGTH	DEPTH
Well Type WAG INJECTION		END OF TAILPIPE			5765.60
	KB			12.00	
	COMPRESSION (10,000#)			-1.50	12.00
1	2 7/8" F.L. PXP NEW	3.094	2.125	31.26	10.50
2	10' X 2 7/8" F.L. NEW	3.668	2.125	10.23	41.76
3	6' X 2 7/8" F.L. NEW	3.668	2.125	6.13	51.99
4	4 151 JNTS 2 7/8" F.L. NEW	3.668	2.125	4872.12	58.12
5	5 2 7/8" B X 2 3/8" P 316 SS X-OVER	3.668	1.995	0.50	4930.24
6	6 25 JNTS 2 3/8" TK-15 NEW	3.063	1.901	774.14	4930.74
7	7 5" PS-1X PKR COATED I&E CARB RHS-RHR	4.125	1.901	6.20	5704.88
8	8 8' X 2 3/8" FGW - TK-15	3.263	1.901	8.17	5711.08
9	9 2 3/8" EXTN ON/OFF SLICK 1.81F 316 SS	3.750	1.810	4.50	5719.25
10	10 6' X 2 7/8" F.L. NEW	3.263	1.901	6.25	5723.75
11	11 5" LOC-SET PKR COATED I&E CARB	4.125	1.901	3.50	5730.00
12	12 1 JNT 2 3/8' FGW - TK-15	3.263	1.901	31.70	5733.50
13	13 2 3/8" WLEG 316 SS	3.063	2.000	0.40	5765.20
					5765.60
8					
	PERFS - 6366 - 5750				
9	CASING TESTED 1200 PSI - GOOD TUBING TESTED 1500 PSI - GOOD				
11					
12					
13					

Prepared for: MR. GABE COLLINS BY: BURT KEY

MILLER PUMPS / PACKERS
1161 E. 1300 S. VERNAL UT.
435-789 0666