


Well Name: WETHINGTON 17-7
WINS No: E2921
API No: 0512333620
State: COLORADO
County: WELD
Field Name: WATTENBERG
Well Directions HWY 85 & HWY 52, S 8/10,W 1/10,N 1/10 INTO

Location Description SE NW 7 1N 66W 1,466' FNL 2,632' FWL
Working Interest 69.92
Spud Date: 09/22/2011
Ground Elevation: 4902
KB Height: 4917
TD Date: 09/25/2011

TD: 7850
TVD: 7594
PBTD: 7824
PB TVD: 7568

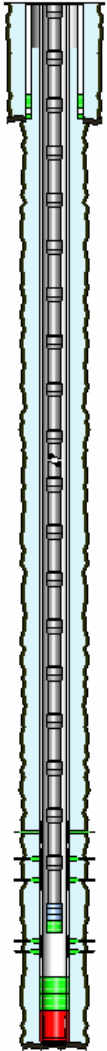

HOLE SECTIONS					LOGGING DATA									
HOLE SECTIONS	Size	Top	Btm	TD Date	Date	Tool Description	MD Top	MD Base						
SURFACE	12.250	15	911	09/23/2011	09/25/2011	DUAL INDUCTION LOG	901	7,832						
PRODUCTION	7.875	911	7850	09/26/2011	09/25/2011	MUD LOG	901	7,832						
					09/25/2011	COMPENSATED NEUTRON	901	7,832						
					09/25/2011	GAMMA RAY	901	7,832						
					09/25/2011	COMPENSATED DENSITY	901	7,832						
CASING/TUBING/WELLBORE EQUIPMENT DATA														
TUBULARS	Tool Type	Joints	Size	Weight	Grade	Thread	Top D	Btm D	Burst	Collapse	Capacity	Length	ID	Drift ID
SURFACE CASING														
	Casing	19	8.625	24.00	J-55	STC	15	856				841.02	8.097	7.972
	Baffle	1	8.625	24.00	J-55	STC	856	856				0.10	8.097	7.972
	Casing	1	8.625	24.00	J-55	STC	856	900				44.30	8.097	7.972
	Saw Tooth Shoe	1	8.625	24.00	J-55	STC	900	901				1.00	8.097	7.972
PRODUCTION CASING														
	Casing	186	4.500	11.60	I-80	LTC	15	7824				7,809.27	4.000	3.875
	Latch Down Baffle	1	4.500	11.60	I-80	LTC	7824	7824				0.01	4.000	3.875
	Shoe Joint	1	4.500	11.60	I-80	LTC	7824	7838				13.42	4.000	3.875
	Casing Float Shoe	1	4.500	11.60	I-80	LTC	7838	7840				1.80	4.000	3.875
PRODUCTION TUBING														
	Tubing	244	2.380	4.70	J-55	8RD EUE	13	7663				7,650.30		
	Seating Nipple	1	2.380	4.70	J-55	8RD EUE	7663	7664				1.00		
	Notched Collar	1	2.380	4.70	J-55	8RD EUE	7664	7665				0.55		
CEMENT INFORMATION														
CEMENT JOBS	Stage	Cement Jobs		Sacks	Returns	Displ. Fluid	Top D	Btm D	cbl					
SURFACE CASING														
	PRIM CMT 1ST STAGE	TAIL	TYPE 3	570			15	901	No					
PRODUCTION CASING														
	PRIM CMT 1ST STAGE	LEAD	PREMIUM LITE	850			701	6,840	Yes					
	PRIM CMT 1ST STAGE	TAIL	50/50 POZ-MIX	170			6,840	7,840	Yes					

Well Name: WETHINGTON 17-7	Location Description SE NW 7 1N 66W 1,466' FNL 2,632' FWL	TD: 7850
WINS No: E2921	Working Interest 69.92	TVD: 7594
API No: 0512333620	Spud Date: 09/22/2011	PBTD: 7824
State: COLORADO	Ground Elevation: 4902	PB TVD: 7568
County: WELD	KB Height: 4917	
Field Name: WATTENBERG	TD Date: 09/25/2011	
Well Directions HWY 85 & HWY 52, S 8/10,W 1/10,N 1/10 INTO		

FORMATION TOPS					PUMP EQUIPMENT	
Strat Unit	Formation	MD Top	MD Base	Comments	Type	Description
	PARKMAN	4,322		ACTUAL		
	NIOBRARA	7,344				
	CODELL	7,680		ACTUAL		
	FORT HAYS					
	DAKOTA					
	SURFACE					
	LAKOTA					
	GREELEY					
	SHANNON UPPER					
	J SAND					
	FOX HILLS					
	TEPEE BUTTES					
	SUSSEX	4,796	5,050	ACTUAL		

PERFORATIONS											
Date	Formation	Zone	Top	Btm	SPF	No. Holes	Diameter	Phasing	Reason	Status	Comments
11/18/2011	NIOBRARA	B	7451	7463	3	36	0.42	120	PRODUCTION	OPEN	
11/18/2011	NIOBRARA	C	7522	7528	3	18	0.42	120	PRODUCTION	OPEN	
11/18/2011	NIOBRARA	C	7538	7544	2	12	0.42	120	PRODUCTION	OPEN	
11/17/2011	CODELL		7682	7700	3	54	0.42	120	PRODUCTION	OPEN	