




Lat40°, Inc. 1635 Foxtrail Drive, Suite 325 Loveland, CO 970-776-3321

WELL LOCATION CERTIFICATE

THIS MAP DOES NOT REPRESENT A BOUNDARY SURVEY

SECTION: 31
TOWNSHIP: 7N
RANGE: 63W

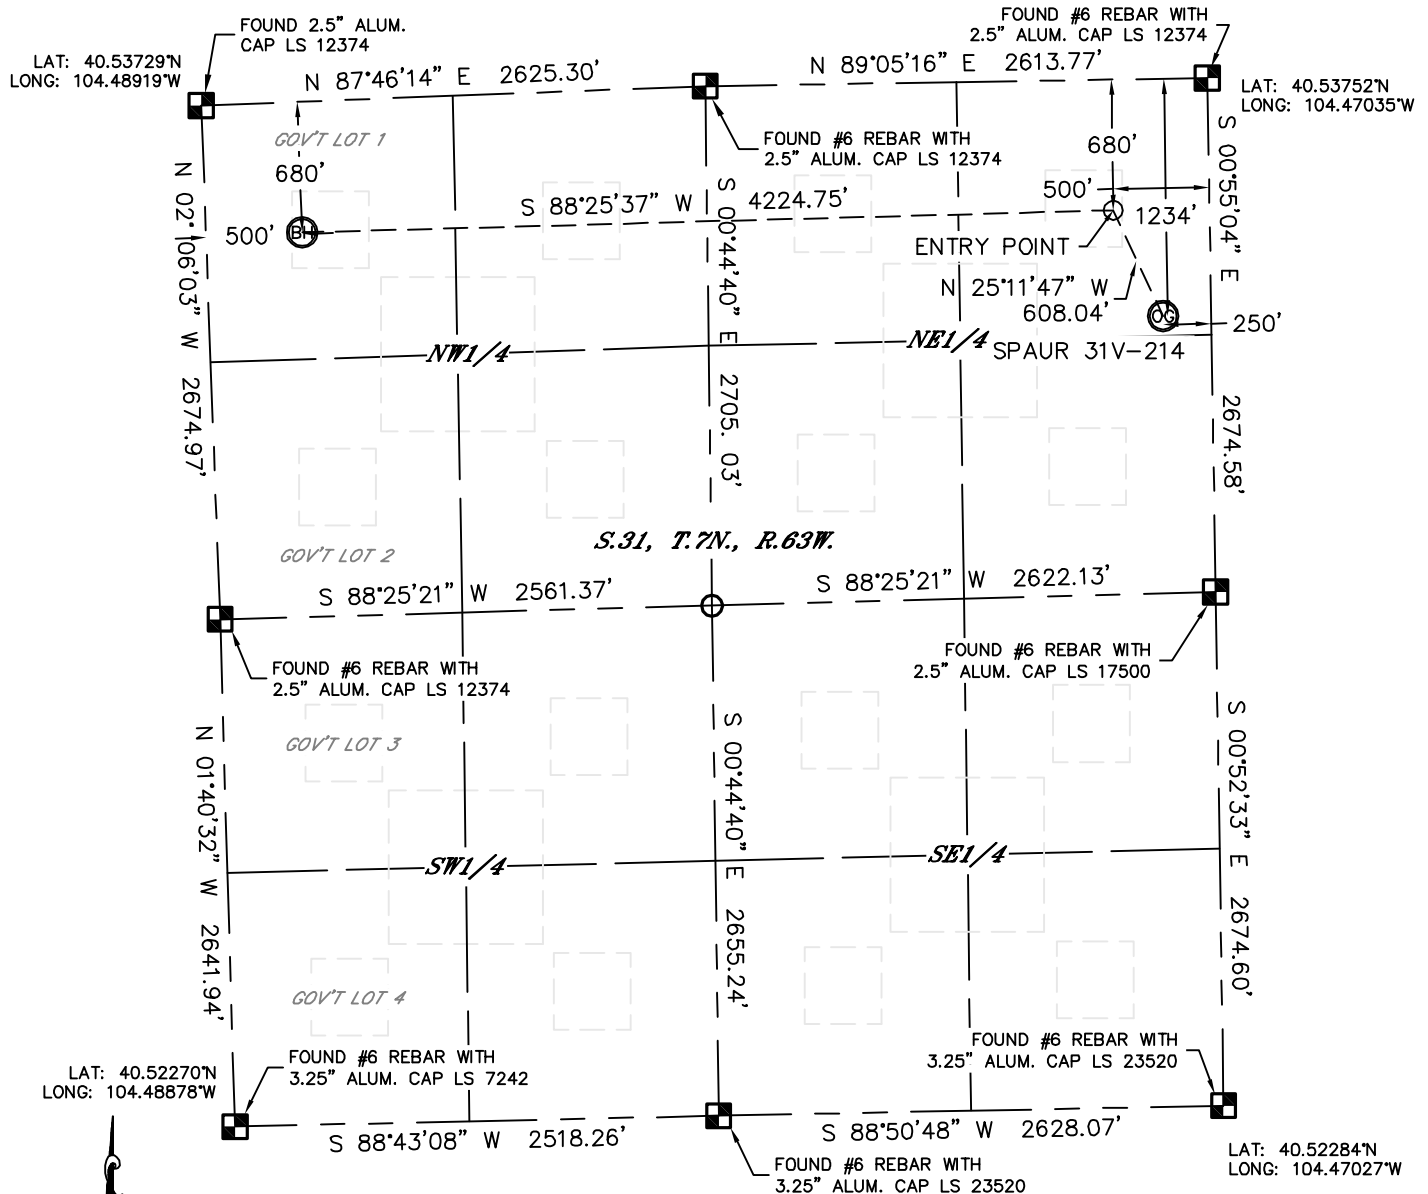

In accordance with a request from Al Bragg with PDC Energy Lat40°, Inc. has determined the surface location of the SPAU 31V-214 to be 1234' from the NORTH line and 250' from the EAST line and the bottom hole to be 680' from the NORTH line and 500' from the WEST line as measured at right angles from the section lines of Section 31, Township 7 North, Range 63 West of the Sixth Principal Meridian, County of Weld, State of Colorado.

I hereby state that this Well Location Certificate was prepared by me, or under my direct supervision, that the fieldwork was completed on 2/16/2012, for and on behalf of PDC Energy That this is not a Land Survey Plat or an Improvement Survey Plat, and that it is not to be relied upon for establishment of fence, building, or other future improvement lines.

NOTE:

- 1) Bearings shown are Grid Bearings of the Colorado State Plane Coordinate System, North Zone, North American Datum 1983/2007. The lineal dimensions as contained herein are based upon the "U.S. Survey Foot."
- 2) Ground elevations are based on an observed GPS elevation (NAVD 1988 DATUM).
- 3) IMPROVEMENTS: See LOCATION DRAWING for all visible improvements within 400' of disturbed area.
- 4) SURFACE USE: CROP LAND
- 5) INSTRUMENT OPERATOR: WYATT HALL

SURFACE LOCATION

LATITUDE: 40.53413°N
LONGITUDE: 104.47123°W
PDOP: 2.6
ELEV: 4758'
1/4,1/4: NE1/4NE1/4
NEAREST PROPERTY LINE: 201' N

BOTTOM HOLE

LATITUDE: 40.53546°N
LONGITUDE: 104.48733°W

ENTRY POINT

LATITUDE: 40.53564°N
LONGITUDE: 104.47214°W

NOTE

According to Colorado law, you must commence any legal action based upon any defect in this W.L.C. within three years after you discover such defect. In no event, may any action based upon any defect in this survey be commenced more than ten years after the date of the certificate shown hereon. (13-80-105 C.R.S.)


LEGEND

- = ALIQUOT MONUMENT AS DESCRIBED
○ = CALCULATED POSITION

Brian T. Brinkman—On behalf of Lat40°, Inc.

Colorado Licensed Professional
Land Surveyor No. 38175


DATE: REV.2/17/2012
PROJECT#: 2011208

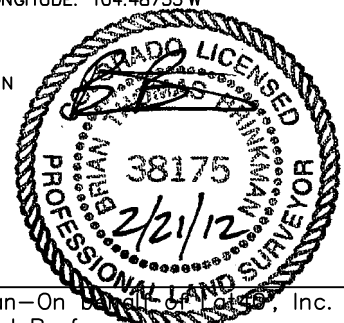

SITE SKETCH

SPAUR 31V-214

SECTION: 31
TOWNSHIP: 7N
RANGE: 63W

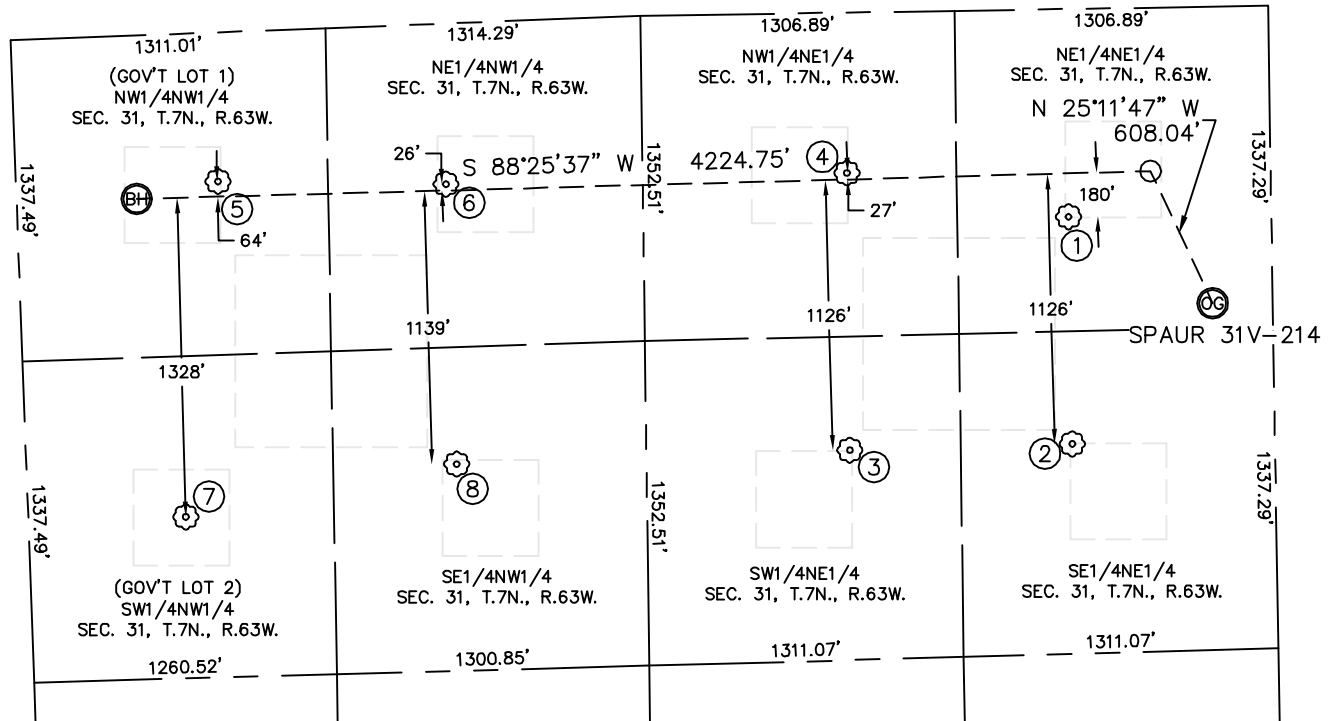

- ① ZAHOREK 41-31
NE1/4NE1/4
864' FNL
845' FEL
LAT-40.53513°N
LONG-104.47337°W
PDOP: 1.2
ELEV: 4778'
 - ② ZAHOREK 42-31
SE1/4NE1/4
1810' FNL
844' FEL
LAT-40.53254°N
LONG-104.47336°W
PDOP: 1.3
ELEV: 4776'
 - ③ ZAHOREK 32-31
SW1/4NE1/4
1821' FNL
1771' FEL
LAT-40.53250°N
LONG-104.47669°W
PDOP: 1.3
ELEV: 4776'
 - ④ ZAHOREK 31-31
NW1/4NE1/4
668' FNL
1765' FEL
LAT-40.53566°N
LONG-104.47669°W
PDOP: 2.1
ELEV: 4795'
 - ⑤ ZAHOREK 11-31
NW1/4NW1/4
620' FNL
841' FWL
LAT-40.53565°N
LONG-104.48611°W
PDOP: 1.6
ELEV: 4760'
 - ⑥ ZAHOREK 21-31
NE1/4NW1/4
668' FNL
1789' FWL
LAT-40.53559°N
LONG-104.48270°W
PDOP: 4.5
ELEV: 4779'
 - ⑦ ZAHOREK 12-31
SW1/4NW1/4
2010' FNL
656' FWL
LAT-40.53182°N
LONG-104.48665°W
PDOP: 1.3
ELEV: 4759'
 - ⑧ ZAHOREK 22-31
SE1/4NW1/4
1834' FNL
1792' FWL
LAT-40.53239°N
LONG-104.48258°W
PDOP: 2.6
ELEV: 4758'

