Encana Oil & Gas (USA) Inc.

Well : **CRANDELL 0-6-26**
Field : **WATTENBERG**
County : **BROOMFIELD** **State : Colorado**
Surface : **1735 FSL, 1008' FWL, NWSW Sec 26-T1N-R68W**
:
:
Grd Elev : **5217' GR** **KB Elev : 5230' KB**

Well History:

Spud 10-18-2011
TD 10-22-2011

Log Tops:

Sussex 4993'
Niobrara 7706'
Codell 8142'
J Sand 8581'

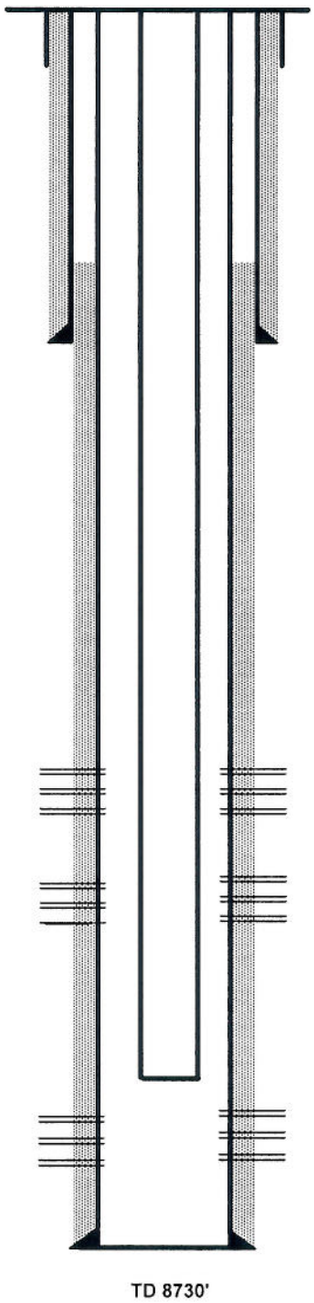

TD 8730'

Surface Casing and Cement
8-5/8", Set @ 1084'
Cemented with 400'

Production Casing and Cement
4-½" production casing set @ 8718'
Cemented with 655 sxs

CBP
Set @ 7660'. 02-05-12
Drilled out on 02-07-12

Perf'd the Niobrara 7710' - 7920' @ 4 spf
Frac'd the Niobrara 7710' – 7920' (180 holes), w/ 106,764 gals 18 # Vistar Hybrid cross linked gel containing 251,080# 30/50 sand. 12-07-11

CFP
Set @ 7980'. 12-06-11
Drilled out on 02-07-12

Perf'd the Codell from 8142' - 8163' @ 2 spf
Frac'd the Codell 8142' – 8163', (42 holes) w/ 90,720 gal 22 # Vistar Hybrid cross linked gel containing 249,840 # 30/50 sand. 12-06-11

Production Tubing
2-3/8", Set @ 8566.80'

CFP
Set @ 8230'. 12-06-11
Drilled out on 02-07-12

Perf'd the J Sand from 8596' - 8620' @ 2 spf
Frac'd the J-Sand 8596'– 8620', (48 holes) w/ 60,732 gal 18 # Vistar Hybrid cross linked gel containing 234,364# 20/40 Sand. 12-05-11

Drawn by:
Sheilla Reed-High