




Lease Name: Margil #22-34D

Legals: SWNW – Sec. 34, T4N, R68W

County: Weld County, Colorado

API#: 05-123-33842

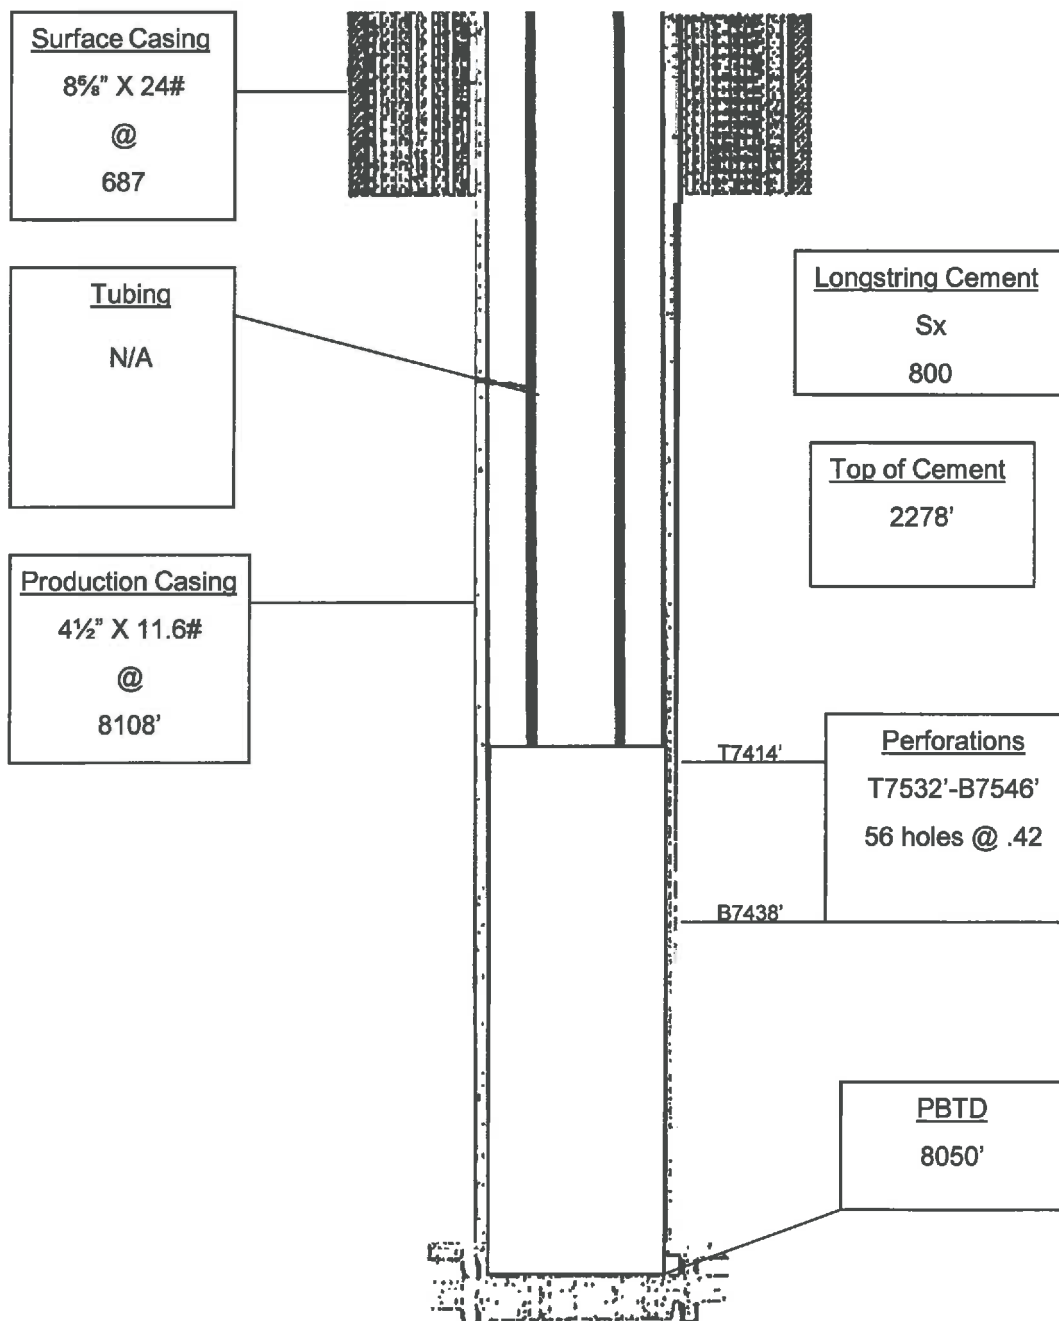

Wellbore Diagram