


Well : CRANDELL 2-8-26
 Field : WATTENBERG
 County : BROOMFIELD State : Colorado
 Surface : 1695 FSL, 1008' FWL, NWSW Sec 26-T1N-R68W
 :
 :
 :
 Grd Elev : 5217' GR KB Elev : 5230' KB

Well History:
 Spud 09-22-2011
 TD 09-26-2011

Log Tops:

Sussex 5145'
 Niobrara 7914'
 Codell 8336'
 J Sand 8742'

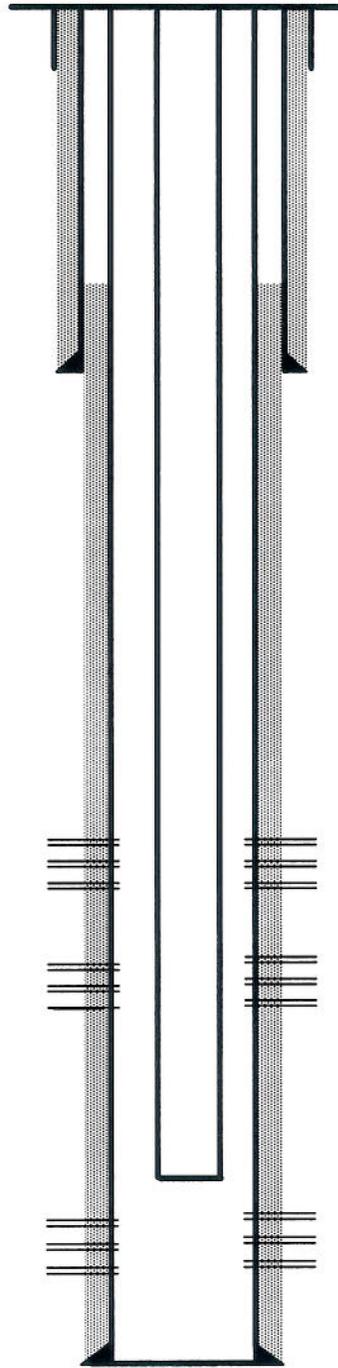

TD 8878'

Surface Casing and Cement

8-5/8", Set @ 1083'
 Cemented with 415'

Production Casing and Cement

4-1/2" production casing set @ 8863'
 Cemented with 670 sxs

CBP

Set @ 7860'. 02-15-12
 Drilled out on 02-16-12

Perf'd the Niobrara 7920' - 8114' @ 4 spf
 Frac'd the Niobrara 7920' - 8114' (184 holes), w/ 98,952
 gals 18 # Vistar Hybrid cross linked gel containing 251,880#
 30/50 sand. 11-22-11

CFP

Set @ 8150'. 11-22-11
 Drilled out on 02-16-12

Perf'd the Codell from 8336' - 8352' @ 2 spf
 Frac'd the Codell 8336' - 8352', (32 holes) w/ 90,468
 gal 22 # Vistar Hybrid cross linked gel containing
 251,100 # 30/50 sand. 11-22-11

CFP

Set @ 8390'. 11-22-11
 Drilled out on 02-16-12

Perf'd the J Sand from 8757' - 8778' @ 2 spf
 Frac'd the J-Sand 8757' - 8778', (42 holes) w/ 66,738 gal
 18 # Vistar Hybrid cross linked gel containing 251,000#
 20/40 Sand. 11-22-11

Production Tubing
 2-3/8", Set @ 8736.03'

Drawn by:
 Sheilla Reed-High