




Operator: Encana Natural Gas
 Well Name: Cedar Bench 6307
 Section, Township, Range: NENE Sec28 T6S R100W
 Field: Cedar Bench
 County, State: Garfield, Colorado
 API Number: 05-045-6527-0000
 Diagram Date: 21-Feb-12

Current Wellbore

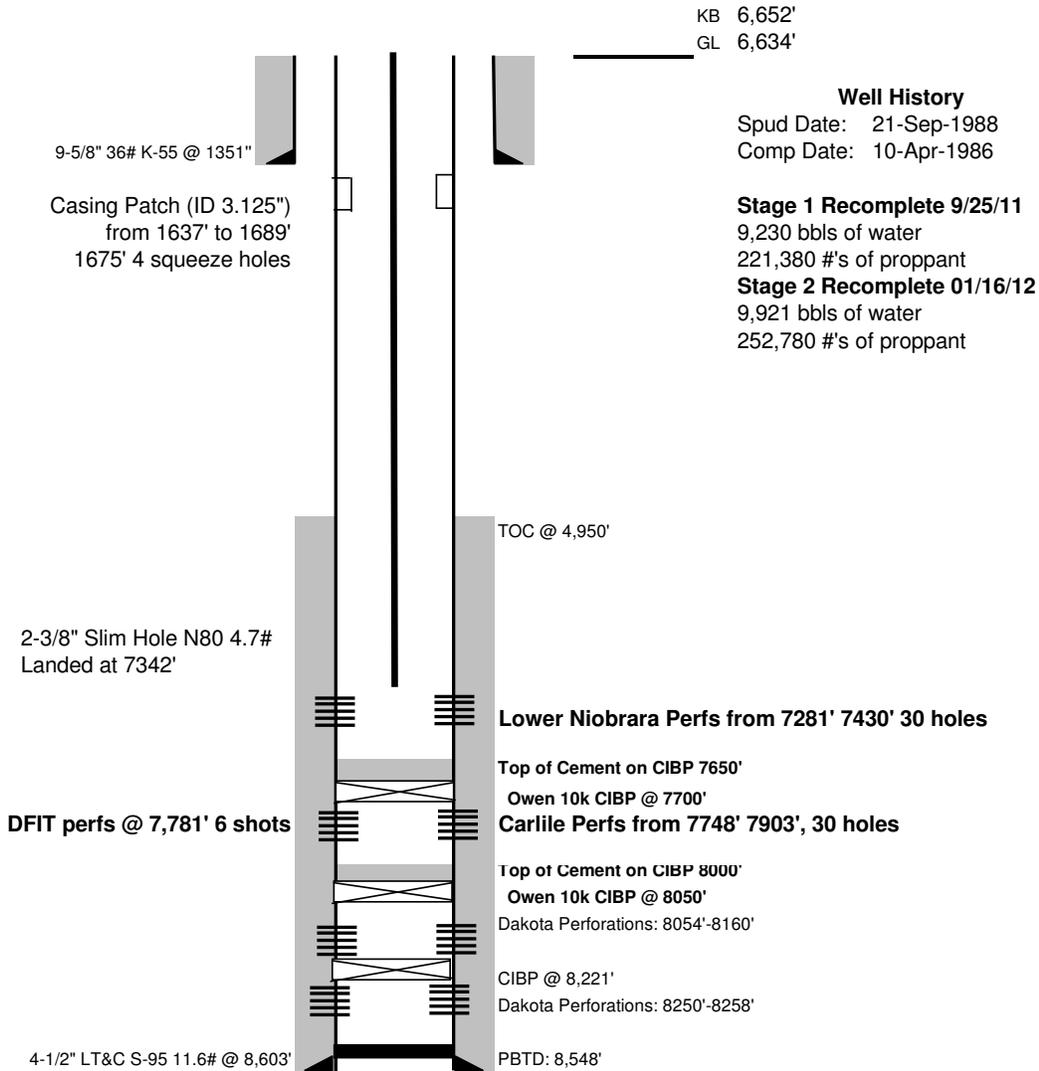

Well History

Spud Date: 21-Sep-1988
 Comp Date: 10-Apr-1986

Stage 1 Recomplete 9/25/11

9,230 bbls of water
 221,380 #'s of proppant

Stage 2 Recomplete 01/16/12

9,921 bbls of water
 252,780 #'s of proppant