
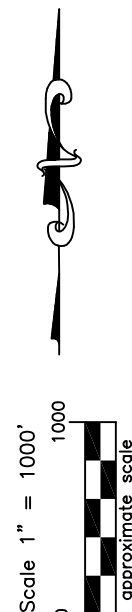


JR Land Surveying, LLC
8114 Northstar Drive
Windsor, Colorado 80528
P. 970-576-4641

WELL LOCATION CERTIFICATE

THIS MAP DOES NOT REPRESENT A BOUNDARY SURVEY

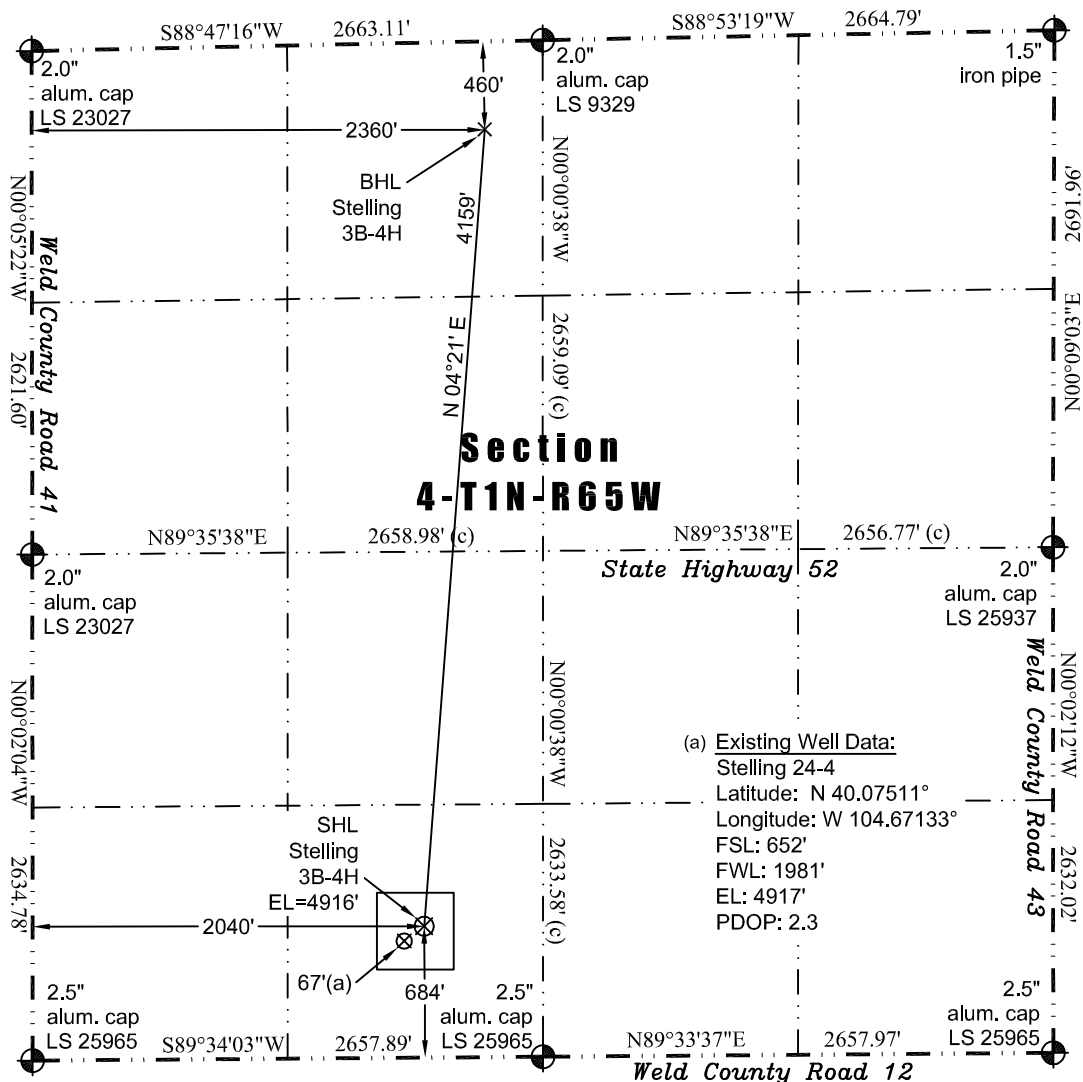

LEGEND
— found survey monument
- - - calculated dimension

In accordance with a request from Jay Knutson of EnCana Oil & Gas (USA) Inc., JR Land Surveying, LLC has determined the location of the **Stelling 3B-4H** well site to be SHL: 684' FSL and 2040' FWL, (BHL: 460 FNL and 2360' FWL) as measured at ninety (90) degrees from the section lines of Section 4, Township 1 North, Range 65 West, 6th Principal Meridian, Weld County, CO.

Proposed Surface Hole Data:

Latitude: N 40.07520° (BHL 40.08657°)
Longitude: W 104.67112° (BHL 104.66985°)
PDOP: 2.4

Nearest:

Building 1,109' east	Above Ground Utility 1,104' east
Public Road 1,241' southeast	Railroad 6,774' southeast
Property Line 684' south	Well Window: SHL is 154' inside
Existing Well: Stelling 24-4, 67' southwest	

Notes:

- 1) Bearings and distances based upon NAD 83 Colorado North State Plane Coordinates using RTK GPS observations taken on 2/28/2012 by operator J.R. McGehee.
- 2) Conversion factor to ground (1.000271498).
- 3) Elevations based on NAVD 88 GPS heights and Geoid 2003 corrections.
- 4) See Location Drawing for visible improvements within 400 feet.
- 5) The surface us is a cultivated field.

I hereby certify that this Well Location Certificate was prepared by me or under my direct supervision on 2/28/2012 for and on behalf of EnCana Oil & Gas (USA) Inc. That it is not a Land Survey Plat or an Improvement Survey Plat and that it is not to be relied upon for establishment of fences, buildings or other future improvement lines.



John Robert McGehee LS#38219
Well: Stelling 3B-4H WLC

NOTICE: According to Colorado law you must commence any legal action based upon any defect in this W.L.C. within three years after you first discover such defect. In no event may any action based upon any defect in this W.L.C. be commenced more than ten years from this said date of the certification shown hereon.