


PICEANCE VLY NAD 83



Well Name: GM 412-27  
 Surface Location: GM 24-27 Pad  
 North American Datum 1983 , US State Plane 1983. Colorado Central Zone  
 Ground Elevation: 5604.0

| +N/-S | +E/-W | Northing   | Easting    | Latitude         | Longitude        | Slot |
|-------|-------|------------|------------|------------------|------------------|------|
| 0.0   | 0.0   | 1614217.80 | 2267652.80 | 39° 29' 27.902 N | 108° 5' 43.090 W | A9   |

KELLY BUSHING @ 5628.0usft (H&P 278 (24') kjs)

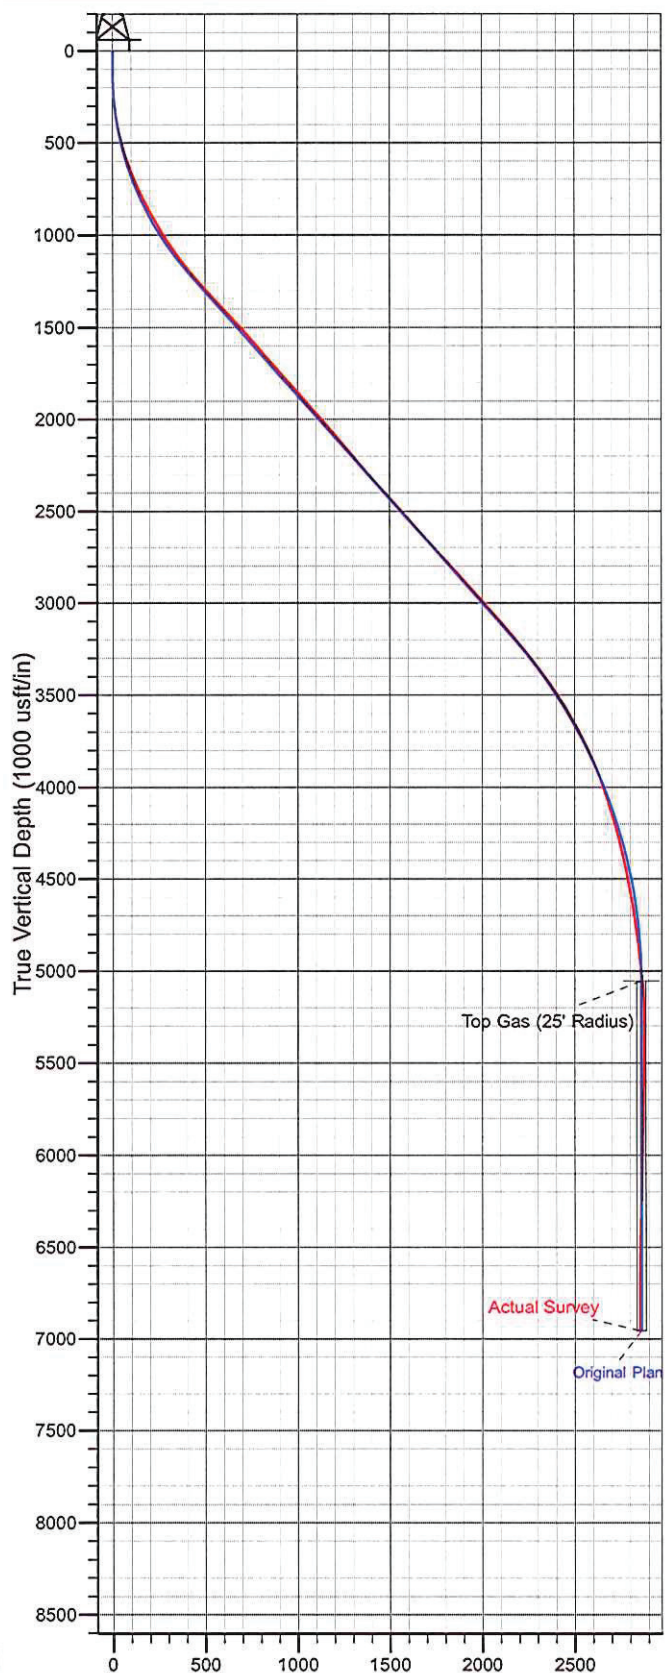

Vertical Section at 305.97° (1000 usft/in)

