
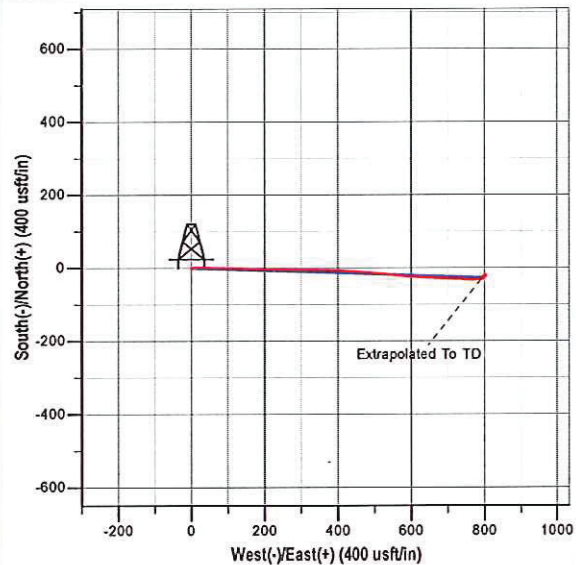


REFERENCE INFORMATION
Magnetic Declination - 10.33°
Magnetic Dip Angle - 65.63°
Field Strength - 52145
Geodetic System - US State Plane 1983
Geodetic Datum - North American Datum 1983
Map Zone - Colorado Central Zone
Est.KB Elevation - KELLY BUSHING @ 5403.0usft (H&P (24' RKB) kjs)
Ground Level - 5379.0
Site Northing - 1577604.70
Site Easting - 2270010.50

TARGET DETAILS

No target data is available.

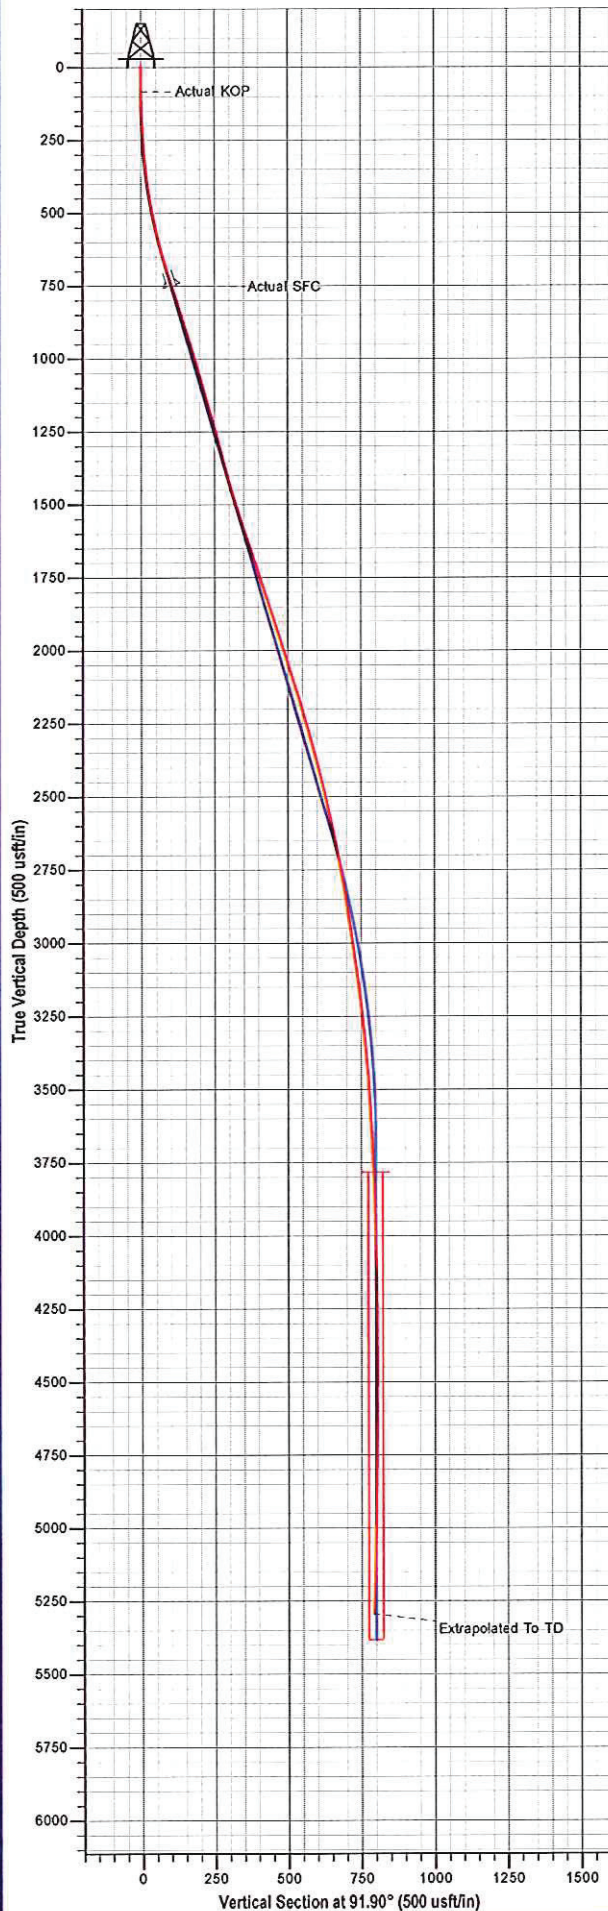

DIRECTIONAL TECHNOLOGIES INC.

Survey: Survey To TD (SG 523-35/11-11-093)

Created By: Brian Varcio Date: 9:46, November 24 2011