




Gulfport Energy Corporation
Downhole Schematic

CURRENT
WELLBORE

WELL NAME:	STATE 41-14-1	FIELD:	Craig (13500)	API:	05-081-07664
SURFACE LOCATION: 698' FNL & 918' FWL (SWSW) Sec 14 - T6N - R91W Moffat County. CO					
ELEVATIONS: KB – CHF 14.6' KB 6351.0' DF 6351.0' GL 6351'				LAT: 40.472404	LONG: -107.577962
B. Osborn 01/18/2012				SPUD DATE: 10/17/2011	

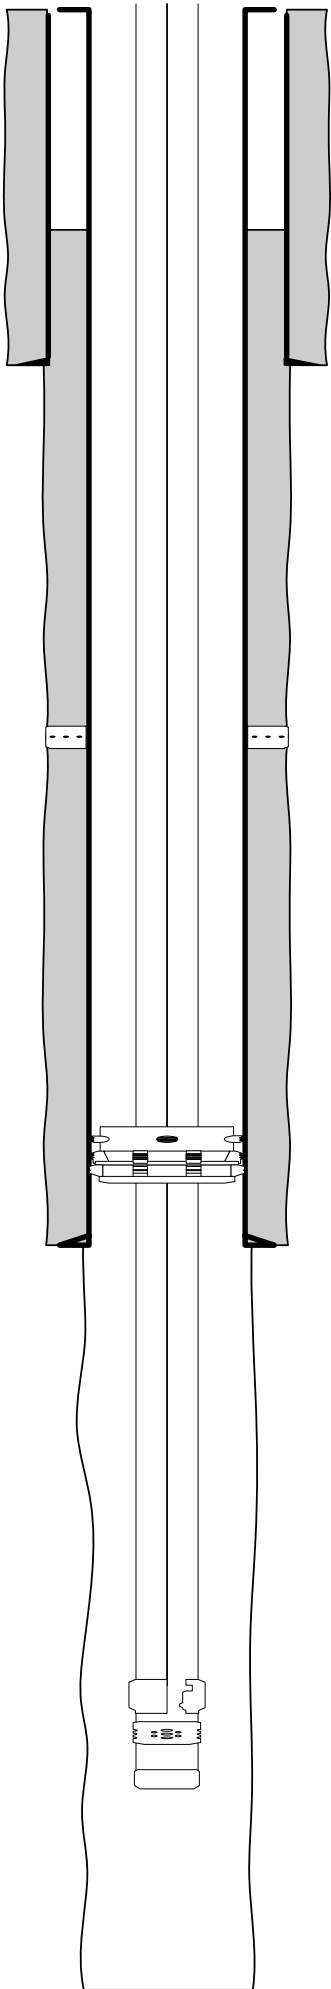

CASING and TUBING INFORMATION					
SIZE	WEIGHT	GRADE	THREAD	DEPTH	HOLE
9 5/8"	36#	J-55	ST&C	0' - 883'	12 1/4"
7"	23#	J-55	LT&C	0' - 6680'	8 3/4"
					6 X 7"
2 7/8"	6.4#	J-55	8rd	0' - 8148'	

16" Drive pipe @ 65'
TOC @ 700' (CBL)
9 5/8" csg @ 883' kb. Cmt'd w/ 178 sxs prem lite & 100 sxs Type 3.

Quantity	Size	Type
2	7/8" x 8'	Pony Rod D
1	7/8" x 6'	Pony Rod D
129	7/8"	D Rods
192	3/4"	D Rods
3	1-1/2"	K Bar
	1/4" x 20'	Pump

DV Tool @ 2350'
TOC @ 2350' (CBL)

Tbg anchor @ 6573'

7" csg @ 6680'
1st stage 281 sxs prem lite & 200 sxs class G
2nd stage 167 sxs prem lite & 100 sxs class G

SN @ 8058'

EOT @ 8148'

TD @ 8695' MD (8657' TVD)

FORMATION	TOP NAME	MD	SS TVD
ILES	ILES	2123	4230
	BASAL ILES SANDSTONE	3361	2993
MANCOS	MANCOS	3466	2888
	RIM ROCK	3616	2738
	MANCOS BENTONITE MKR	4252	2102
	MORAPOS SS	4343	2012
	M KM LOW RES	4666	1689
	LOWER MANCOS MKR	5565	791
	BASAL MANCOS MKR	6696	-332
NIOBRARA	NIOBRARA	7032	-665
	NIOBRARA HOT SHALE	7060	-692
	BASE BUCK PEAK	7110	-742
	TOW CREEK	7464	-1093
	BASE TOW CREEK	7570	-1198
	WOLF MTN	7780	-1406
	BASE WOLF MTN	7933	-1558
	LOWER NIOBRARA MARKER	8128	-1751
	RANGELY BENCH	8297	-1918
	BASAL NIOBRARA MARKER	8382	-2002
CARLILE SH	CARLILE SH	8631	-2245
	TD	8695	-2306