


WELL LOCATION CERTIFICATE


SECTION: 34
TOWNSHIP: 6N
RANGE: 65W

THIS MAP DOES NOT REPRESENT A BOUNDARY SURVEY

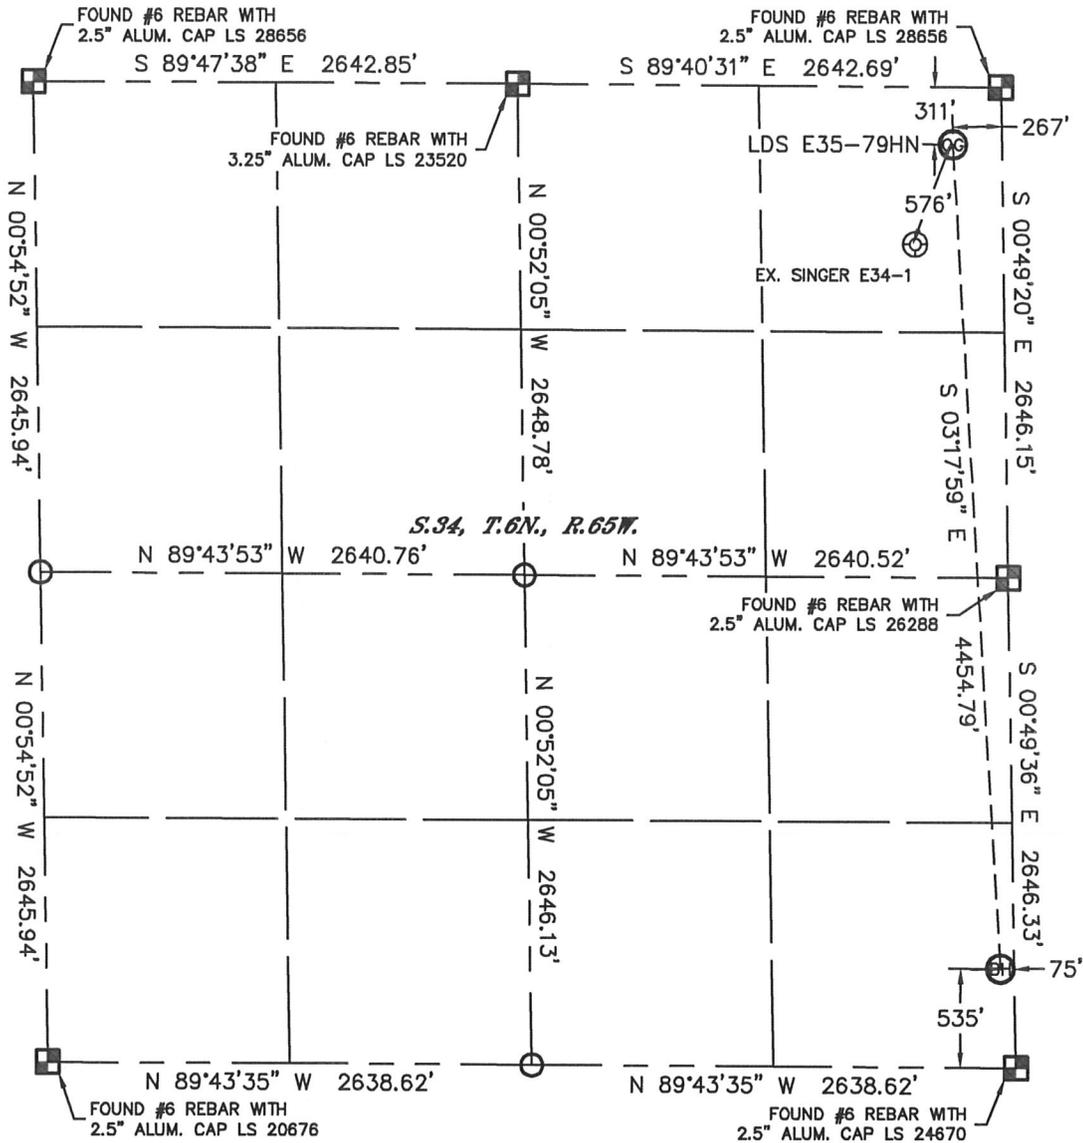

In accordance with a request from Matthew Campbell with Noble Energy Inc. Lat40°, Inc. has determined the surface location of the LDS E35-79HN to be 311' from the NORTH line and 267' from the EAST line and the bottom hole to be 535' from the SOUTH line and 75' from the EAST line as measured at right angles from the section lines of Section 34, Township 6 North, Range 65 West of the Sixth Principal Meridian, County of Weld, State of Colorado.

I hereby state that this Well Location Certificate was prepared by me, or under my direct supervision, that the fieldwork was completed on 10/17/11, for and on behalf of Noble Energy Inc. That this is not a Land Survey Plat or an Improvement Survey Plat, and that it is not to be relied upon for establishment of fence, building, or other future improvement lines.

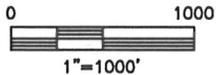

NOTE:

- 1) Bearings shown are Grid Bearings of the Colorado State Plane Coordinate System, North Zone, North American Datum 1983/2007. The lineal dimensions as contained herein are based upon the "U.S. Survey Foot."
- 2) Ground elevations are based on an observed GPS elevation (NAVD 1988 DATUM).
- 3) NEAREST EXISTING WELL: SINGER E34-1, 576'
- 4) IMPROVEMENTS: See LOCATION DRAWING for all visible Improvements within 400' of disturbed area.
- 5) SURFACE USE: CROP LAND
- 6) INSTRUMENT OPERATOR: ADAM KELLY

SURFACE LOCATION
LATITUDE: 40.44881°N
LONGITUDE: 104.64077°W
PDOP: 2.3
ELEV: 4681'
1/4, 1/4: NE1/4NE1/4
NEAREST PROPERTY LINE: 267' E

BOTTOM HOLE
LATITUDE: 40.43660°N
LONGITUDE: 104.64000°W



NOTE

According to Colorado law, you must commence any legal action based upon any defect in this W.L.C. within three years after you discover such defect. In no event, may any action based upon any defect in this survey be commenced more than ten years after the date of the certificate shown hereon. (13-80-105 C.R.S.)

LEGEND

-  = ALIQUOT MONUMENT AS DESCRIBED
-  = CALCULATED POSITION


Brian T. Brinkman—On Behalf of Lat40°, Inc.
Colorado Licensed Professional
Land Surveyor No. 38175

PROJECT#: 2011293

SITE SKETCH

LDS E35-79HN

SECTION: 34
TOWNSHIP: 6N
RANGE: 65W

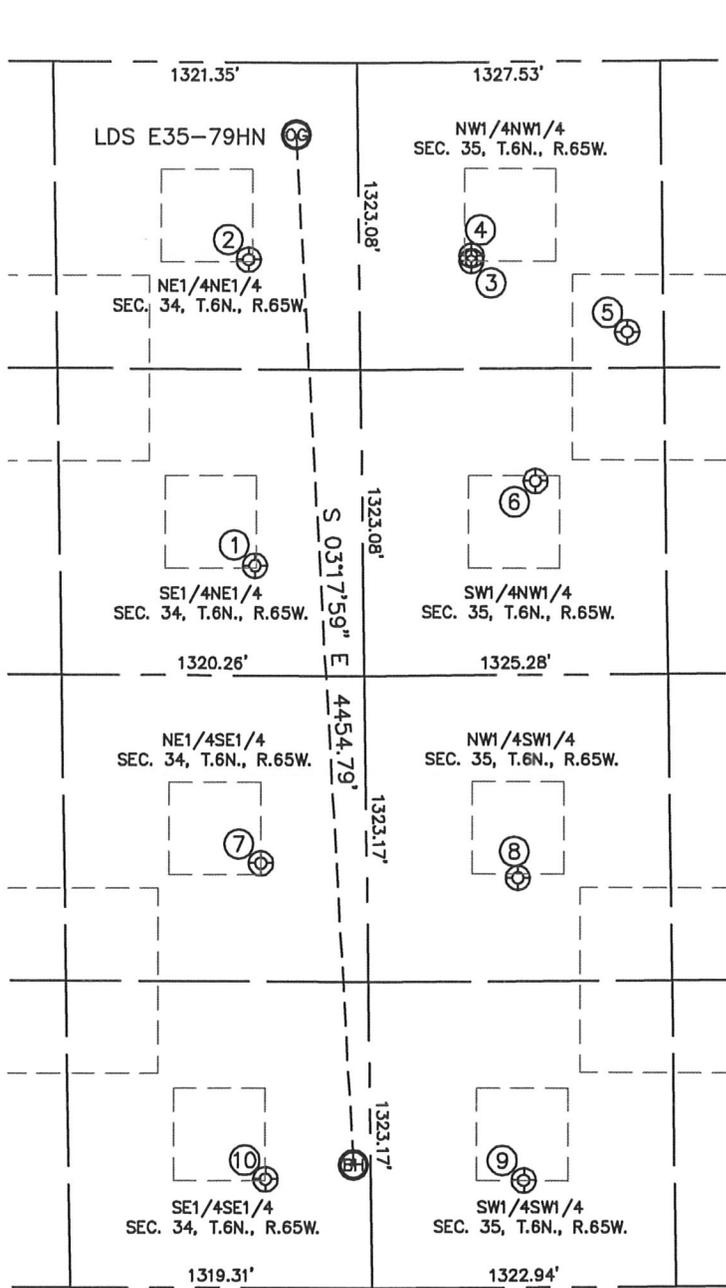

①
SINGER E34-8
SE1/4NE1/4
2171' FNL
469' FEL
LAT-40.44371°N
LONG-104.64147°W
PDOP: 1.2
ELEV: 4669'

②
SINGER E34-1
NE1/4NE1/4
850' FNL
481' FEL
LAT-40.44734°N
LONG-104.64153°W
PDOP: 3.4
ELEV: 4677'

③
CSU E35-04
NW1/4NW1/4
858' FNL
490' FWL
LAT-40.44730°N
LONG-104.63804°W
PDOP: 1.2
ELEV: 4674'

④
CSU E35-3D
NW1/4NW1/4
835' FNL
491' FWL
LAT-40.44736°N
LONG-104.63804°W
PDOP: 1.1
ELEV: 4674'

⑤
CSU E35-19
NW1/4NW1/4
1170' FNL
1168' FWL
LAT-40.44645°N
LONG-104.63560°W
PDOP: 1.8
ELEV: 4671'

⑥
WARREN E35-05
SW1/4NW1/4
1809' FNL
759' FWL
LAT-40.44469°N
LONG-104.63706°W
PDOP: 1.8
ELEV: 4668'

⑦
SINGER E34-9
NE1/4SE1/4
1835' FSL
461' FEL
LAT-40.44018°N
LONG-104.64141°W
PDOP: 2.6
ELEV: 4666'

⑧
WARREN E35-12
NW1/4SW1/4
1770' FSL
659' FWL
LAT-40.43999°N
LONG-104.63739°W
PDOP: 5.0
ELEV: 4663'

⑨
WARREN B35-13
SW1/4SW1/4
483' FSL
666' FWL
LAT-40.43640°N
LONG-104.63734°W
PDOP: 2.7
ELEV: 4659'

⑩
SINGER E34-16
SE1/4SE1/4
470' FSL
459' FEL
LAT-40.43644°N
LONG-104.64138°W
PDOP: 5.1
ELEV: 4661'

