


**WPX Energy Rocky Mountain Company, LLC
Jolley KP 21-17
Kokopelli Field**

**SHL 188' FSL 2333' FWL (SE/4 SW/4) BHL 140' FNL 2012' FWL (NE/4 NW/4, Sec. 17, T6S, R91W)
Section 8, T6S, R91W 6TH PM
Williams Production RMT Co.
Garfield County, Colorado**

**Formation Tops
(Measured Depths)**

**PBTD @
TMD @ 7395'
TVD @ 7365'**

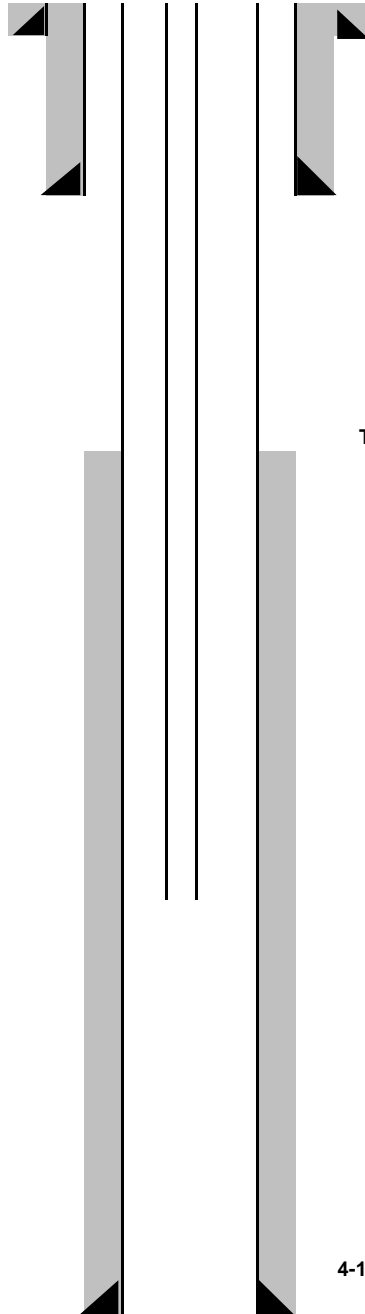

Conductor 26" Hole 18" casing/liner 95' W/34 sks cmt

Cmt @ Surface - (Cmt circ to surf during cmt job)

**9 5/8" 32.3# ppf Csg. Set @ 1251'
In 12 1/4" Hole W/340 Sks. Cmt**

Top Of Cement 2832'

4-1/2", 11.6 ppf. Csg. Set @ 7375' W/1205 sks Cmt