Well Name:	Lovely 14-09	BILL BARRETT CORPORATION	
SHL:	SWSW Sec. 9 T6N, R66W 6th PM	date updated	4/3/2012
		updated by	Brady Riley

05-123-22620 AS DRILLED

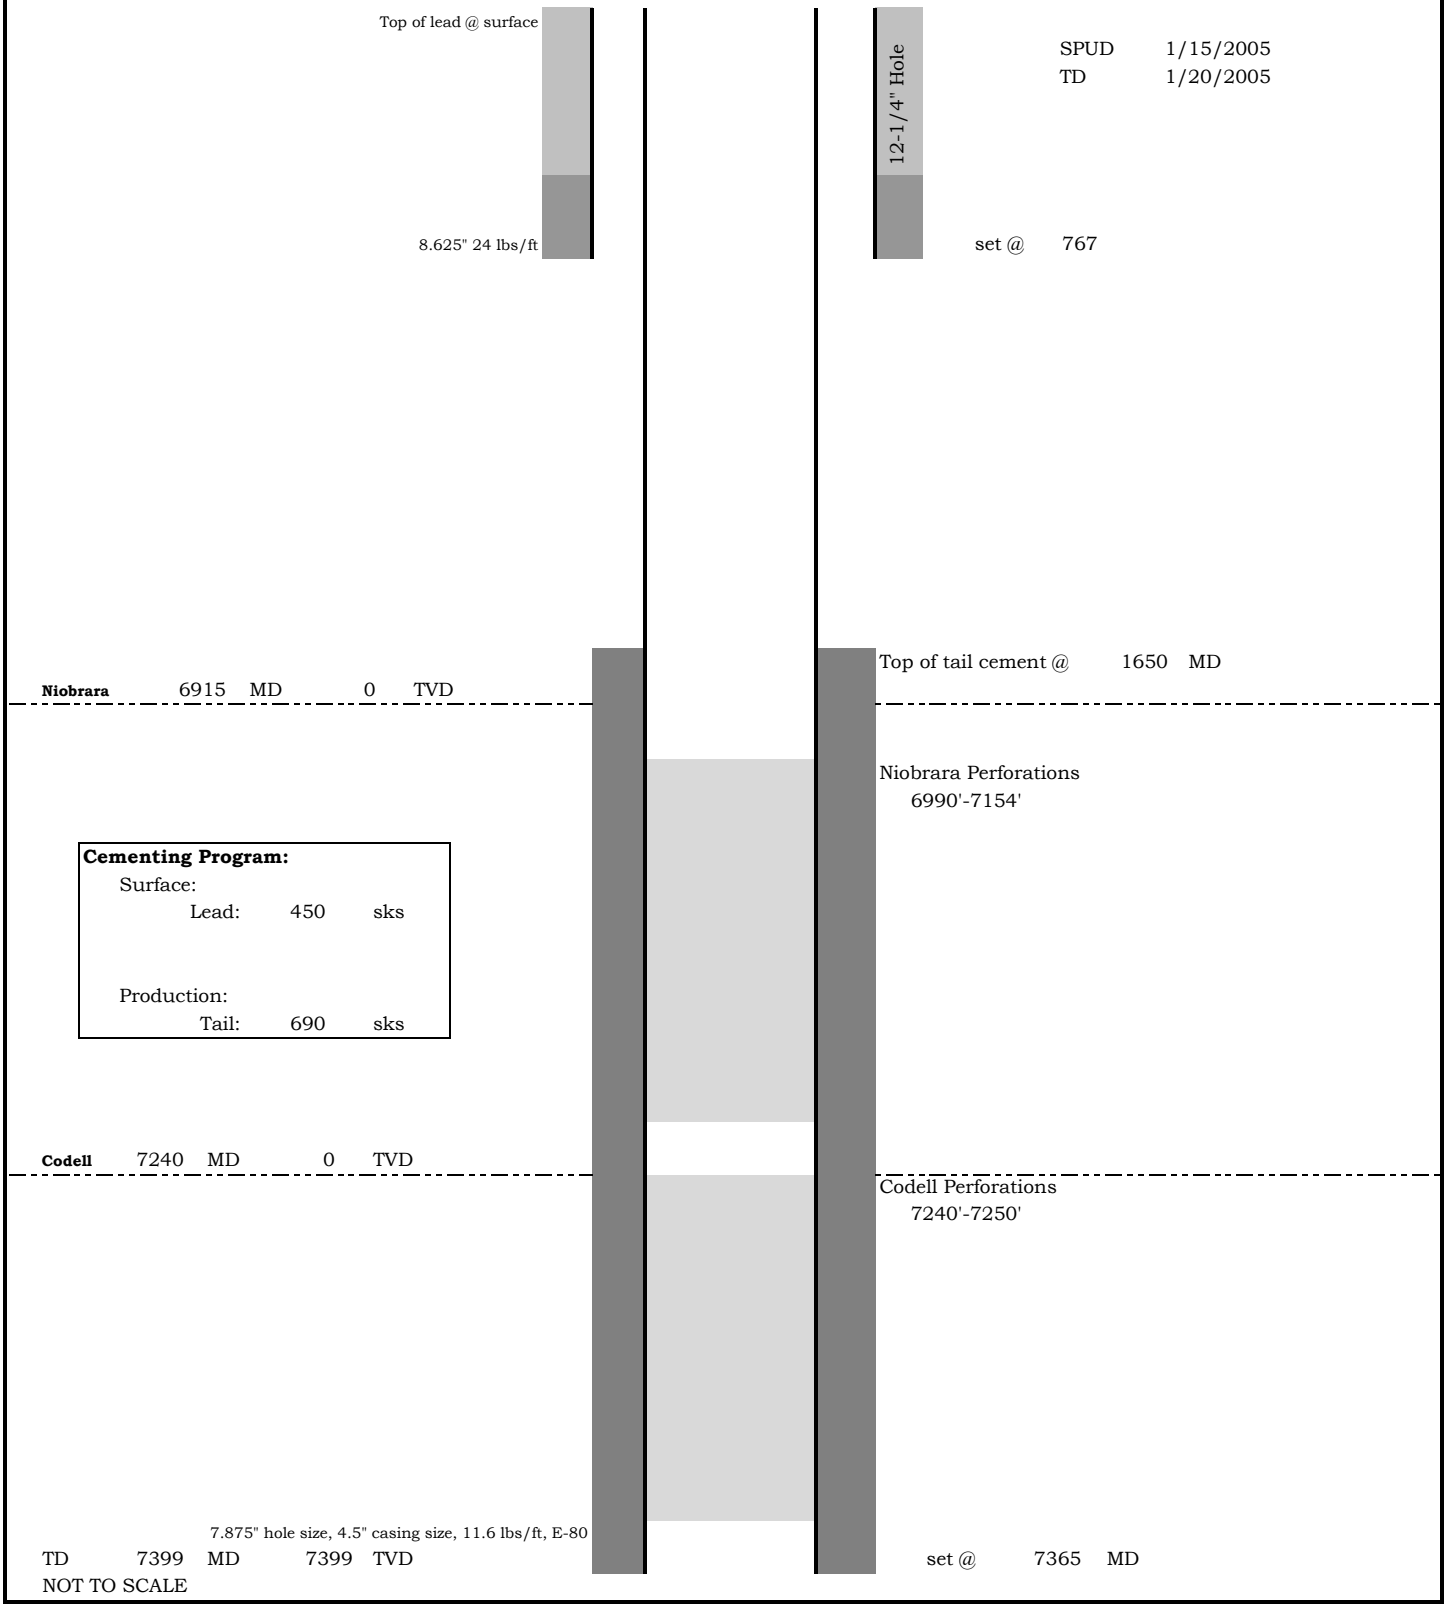

NOT TO SCALE