


WELL LOCATION CERTIFICATE

THIS MAP IS A GIS EXHIBIT AND DOES NOT REPRESENT A BOUNDARY SURVEY.

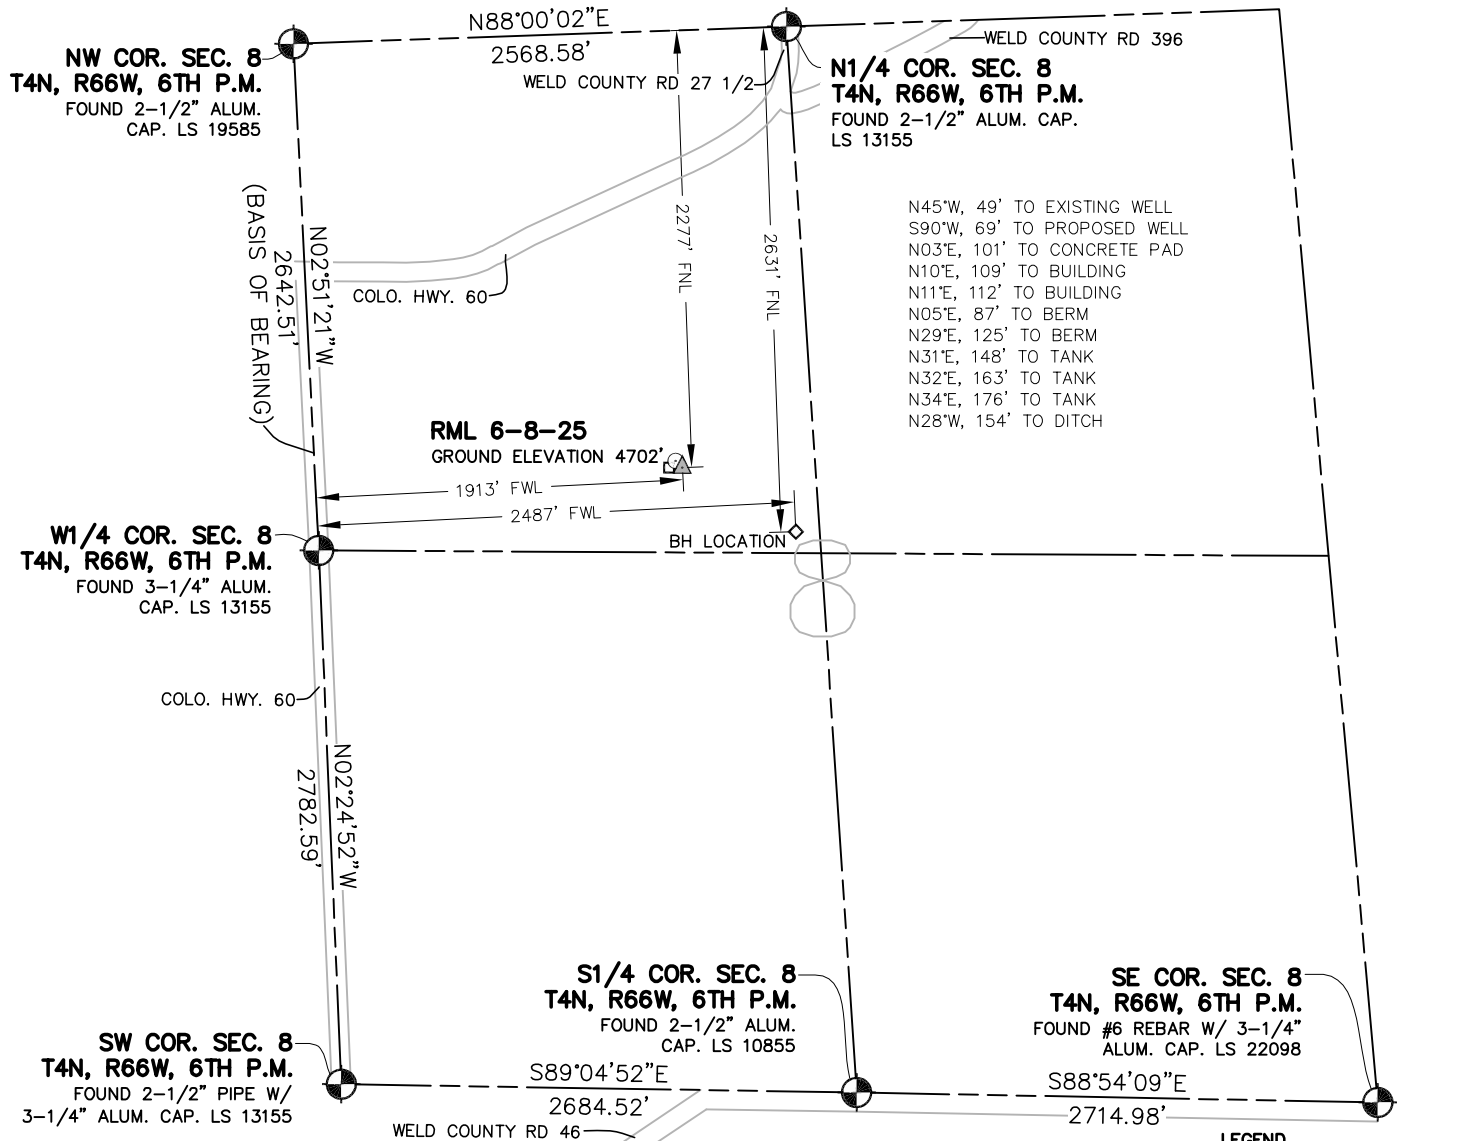

WELL LOCATION CERTIFICATE

IN ACCORDANCE WITH A REQUEST FROM SUSANA LARA-MESA OF KP KAUFFMAN INC., CIVILARTS, INC. HAS DETERMINED THE LOCATION OF RML 6-8-25 WELL SITE TO BE 1913' FWL AND 2277' FNL AS MEASURED AT NINETY (90) DEGREES FROM THE SECTION LINES OF SECTION 8, T4N, R66W, OF THE 6TH P.M., WELD COUNTY, CO.

LEGEND

- = FOUND SURVEY MONUMENT
- = ROAD
- (C) = CALCULATED DIMENSION
- ▲ = PROPOSED WELL LOCATION
- ◇ = BOTTOM OF HOLE LOCATION
- = OTHER PROPOSED WELL LOCATION
- = EXISTING WELL LOCATION

NOTES

1. BEARINGS SHOWN ON THIS MAP ARE BASED UPON GPS OBSERVATIONS MADE ON 12/21/2011 BY BOB THAYER BETWEEN THE W1/4 CORNER AND THE NW CORNER OF SECTION 8, T4N, R66W, OF THE 6TH P.M., HAVING A BEARING OF N02°51'21"W, AS MONUMENTED AND SHOWN HEREON.
2. ELEVATIONS ARE BASED UPON NAVD 88 DATUM.
3. THE LOCATION FALLS IN AN AGRICULTURAL FIELD.

PROPOSED SURFACE HOLE DATA

(NAD 83)
LATITUDE: 40.328066 N
LONGITUDE: 104.804860 W
PDOP: <2.6

NOTICE

ACCORDING TO COLORADO LAW YOU MUST COMMENCE ANY LEGAL ACTION BASED UPON ANY DEFECT IN THIS SURVEY WITHIN THREE YEARS AFTER YOU FIRST DISCOVERED SUCH DEFECT. IN NO EVENT MAY ANY ACTION BASED UPON ANY DEFECT IN THIS SURVEY BE COMMENCED MORE THAN TEN YEARS FROM THE DATE OF THE CERTIFICATION SHOWN HEREON.

I HEREBY CERTIFY THAT THIS WELL LOCATION CERTIFICATE WAS PREPARED UNDER MY RESPONSIBLE CHARGE ON JANUARY 09, 2012 FOR AND ON BEHALF OF KP KAUFFMAN, INC. THAT IT IS NOT A LAND SURVEY PLAT OR AN IMPROVEMENT SURVEY PLAT AND THAT IT IS NOT TO BE RELIED UPON FOR ESTABLISHMENT OF FENCE, BUILDING, OR OTHER FUTURE IMPROVEMENT LINES.

PETER D. STEGER
COLORADO REGISTERED PROFESSIONAL
LAND SURVEYOR NO. 25379

DATE: JANUARY 10, 2012



ENGINEERING
PLANNING
SURVEYING
1860 Lefthand Circle, Suite A
Longmont, CO 80501
P 303.682.1131
F 303.682.1149