Well Name:	**Trant 32C-21-692**	**BILL BARRETT CORPORATION**	
SHL:	SENE Sec. 21 T6S, R92W 6th PM	date updated	**3/27/2012**
		updated by	**Megan Finnegan**
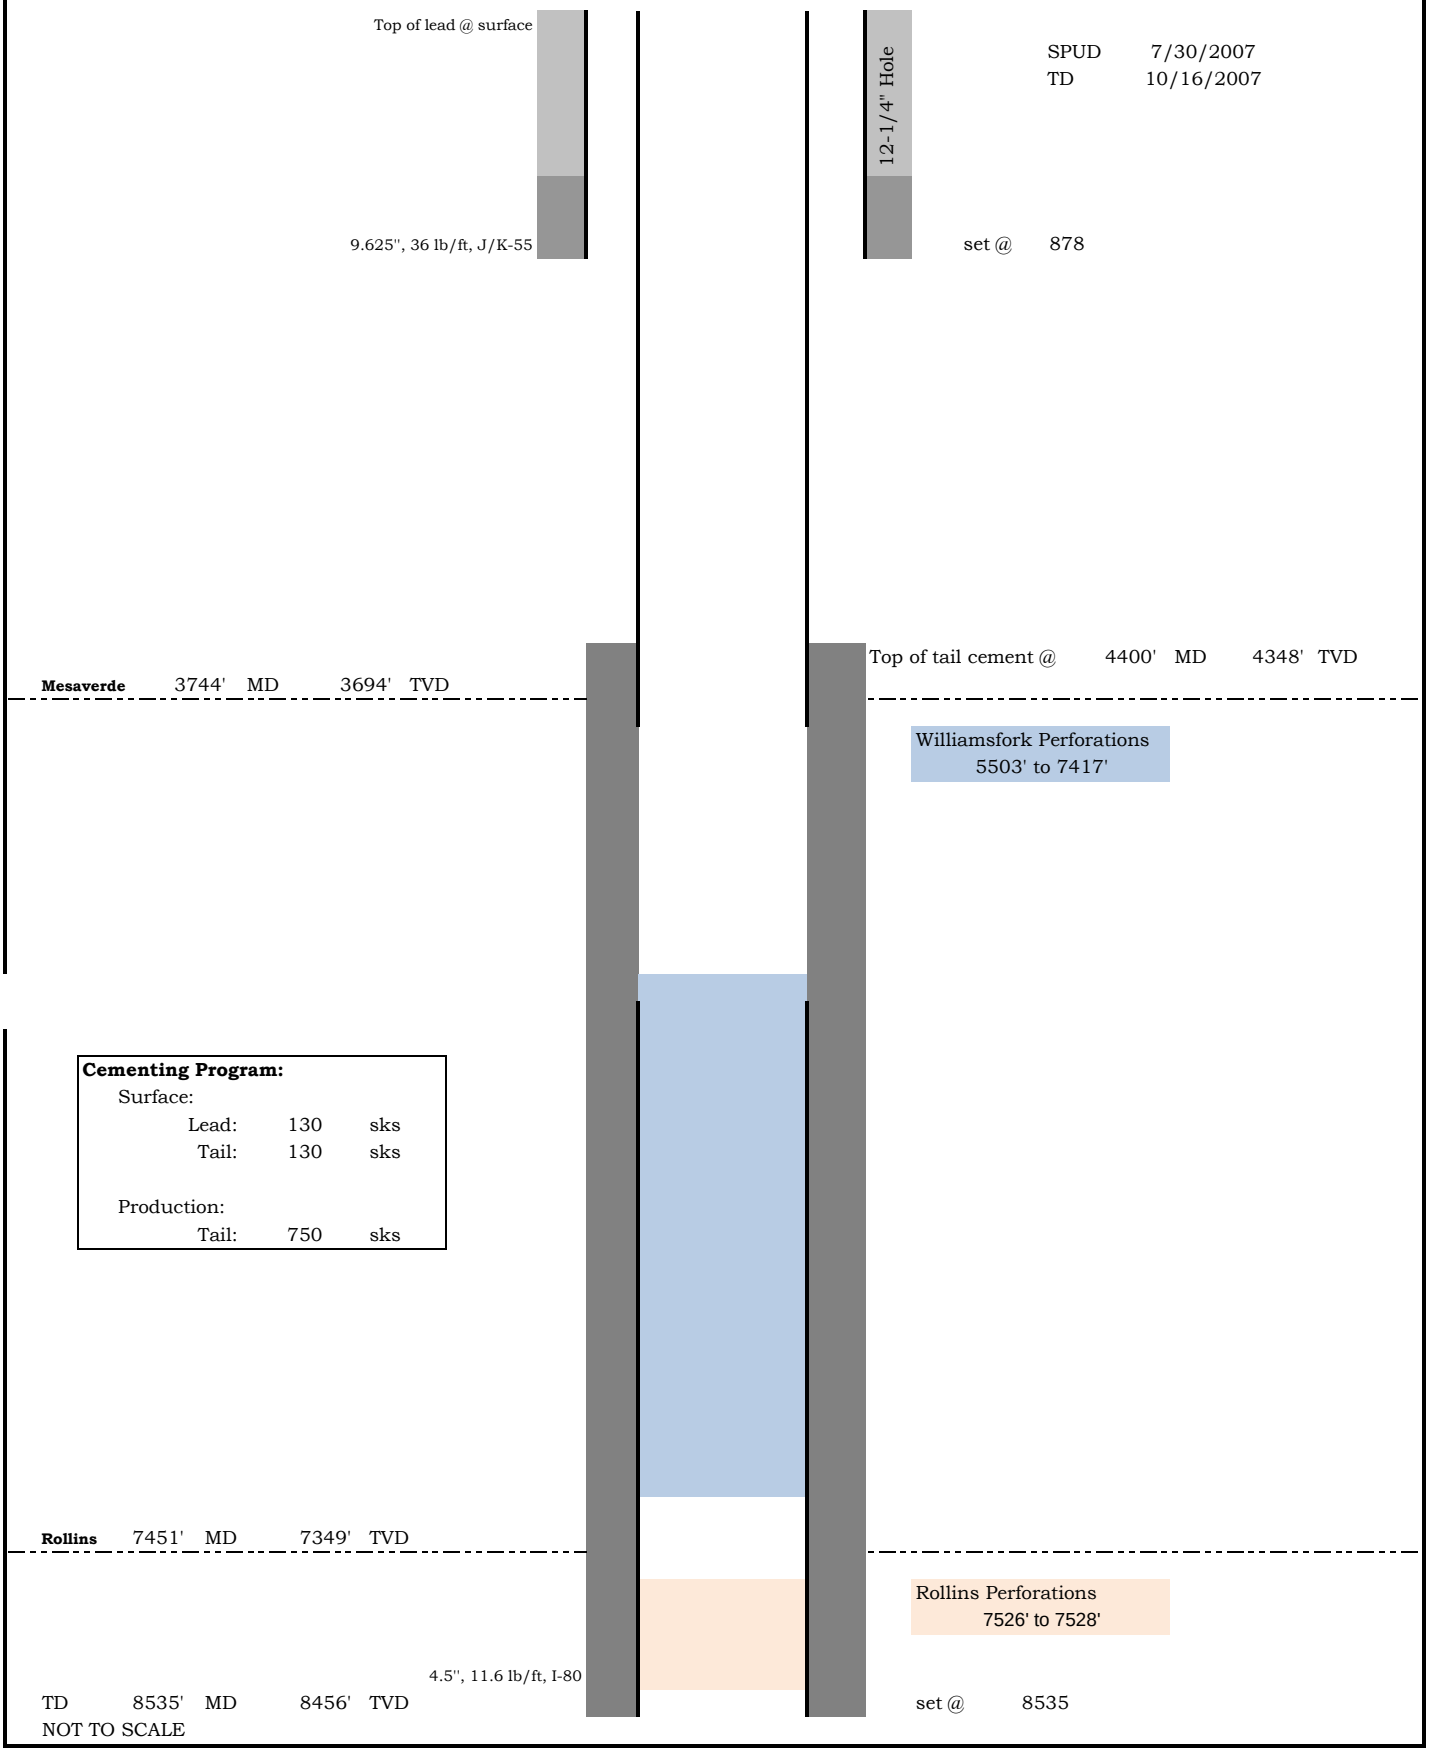
05-045-11848-01