

Well : JILLSON 2-8-22  
 Field : WATTENBERG  
 County : WELD COUNTY State : Colorado  
 Surface : 962' FSL, 1680' FWL, SESW Sec 22-T2N-R68W  
 :  
 :  
 Grd Elev : 4968' GR KB Elev : 4981' KB

**Well History:**

Spud 11-13-2011  
 TD 11-16-2011

Log Tops:

Sussex 4433'  
 Niobrara 7447'  
 Codell 7732'  
 J Sand 8158'

**Surface Casing and Cement**

8-5/8", Set @755'  
 Cemented with 310 sxs

**Production Casing and Cement**

4-1/2" production casing set @ 8275'  
 Cemented with 700 sx

Perf'd the Niobrara 7510' - 7535' @ 4 spf  
 Frac'd the Niobrara 7510' - 7535' (100 holes), w/ 99,414  
 gals 18 # pHaserFrac Hybrid cross linked gel containing  
 250,000# 30/50 sand. 12-14-11


**CFP**  
 Set @ 7590. 12-14-11  
 Drilled out on 03-06-12

Perf'd the Codell from 7732' - 7754' @ 2 spf  
 Frac'd the Codell 7732' - 7754', (44 holes) w/ 90,258  
 gal 22 # pHaserFrac Hybrid cross linked gel  
 containing 250,000 # 30/50 sand. 12-14-11

**CFP**  
 Set @ 7800'. 12-14-11  
 Drilled out on 03-06-11

Perf'd the J Sand from 8168' - 8192' @ 2 spf  
 Frac'd the J-Sand 8168' - 8192', (48 holes) w/ 63,756 gal  
 18 # pHaserFrac Hybrid cross linked gel containing  
 250,500# 20/40 Sand. 12-14-11

**Production Tubing**  
 2-3/8", Set @ 8134'

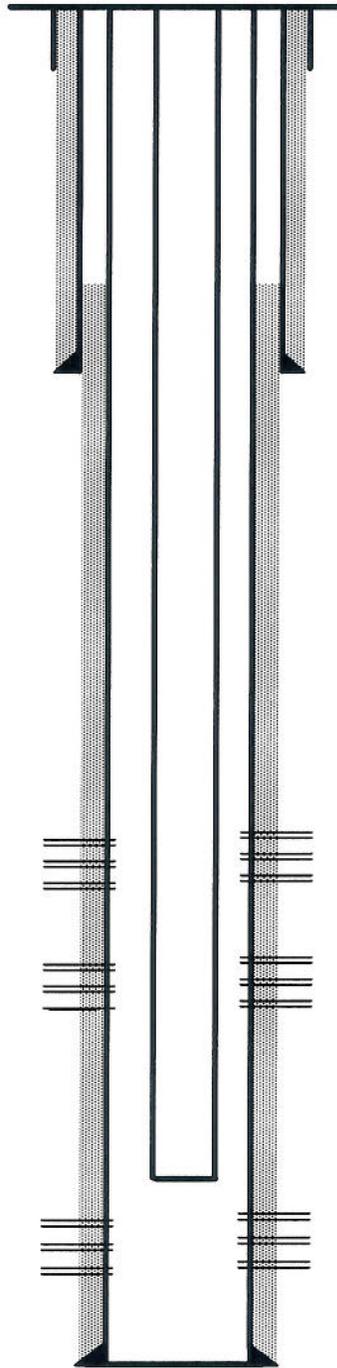

TD 8287'

Drawn by:  
 Sheilla Reed-High