| Well Name: | CBS 42D-21-692 | BILL BARRETT CORPORATION | |
|---|---|---|---|
| SHL: | SWNE Sec. 21 T6S R92W 6th PM | date updated | 3/29/2012 |
| | | updated by | Megan Finnegan |
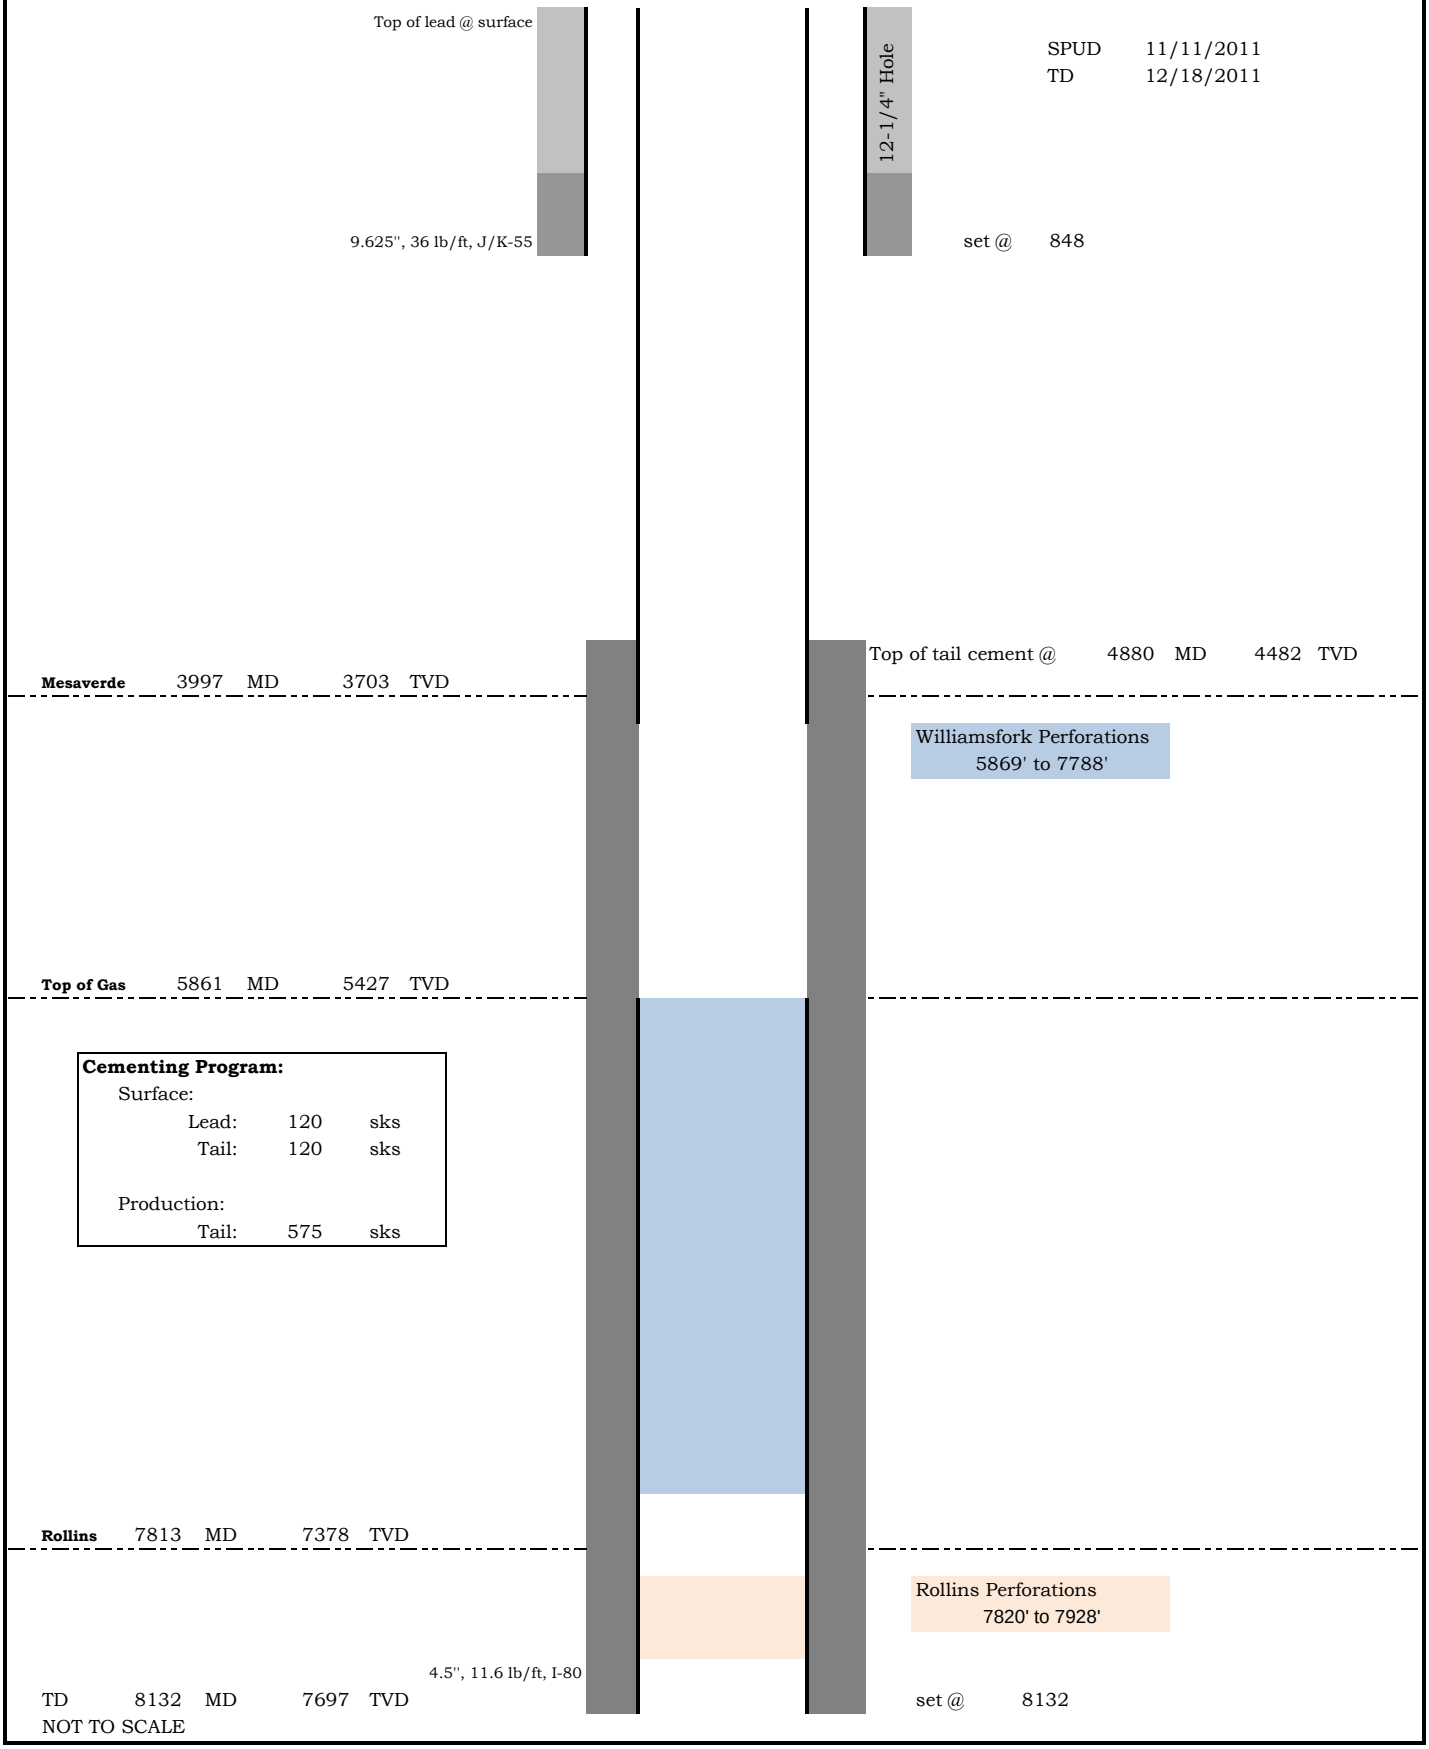
05-045-20126