


WELL LOCATION CERTIFICATE


SECTION: 6
TOWNSHIP: 2N
RANGE: 65W

THIS MAP DOES NOT REPRESENT A BOUNDARY SURVEY

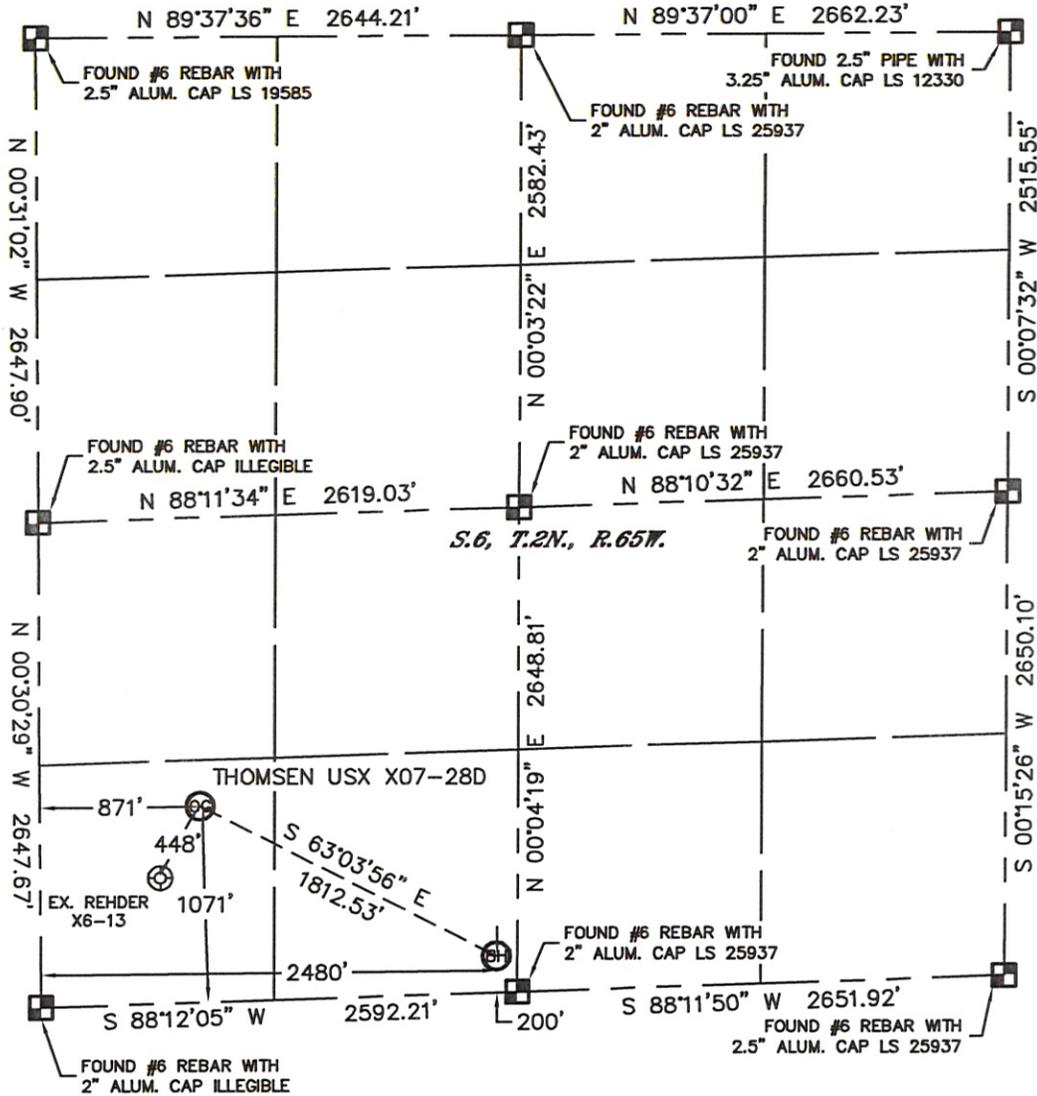

In accordance with a request from Ryan Hawkins with Noble Energy Inc. Lat40°, Inc. has determined the surface location of the THOMSEN USX X07-28D to be 1071' from the SOUTH line and 871' from the WEST line and the bottom hole to be 200' from the SOUTH line and 2480' from the WEST line as measured at right angles from the section lines of Section 6, Township 2 North, Range 65 West of the Sixth Principal Meridian, County of Weld, State of Colorado.

I hereby state that this Well Location Certificate was prepared by me, or under my direct supervision, that the fieldwork was completed on 12/9/11, for and on behalf of Noble Energy Inc. That this is not a Land Survey Plat or an Improvement Survey Plat, and that it is not to be relied upon for establishment of fence, building, or other future improvement lines.

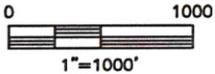

NOTE:

- 1) Bearings shown are Grid Bearings of the Colorado State Plane Coordinate System, North Zone, North American Datum 1983/2007. The lineal dimensions as contained herein are based upon the "U.S. Survey Foot."
- 2) Ground elevations are based on an observed GPS elevation (NAVD 1988 DATUM).
- 3) NEAREST EXISTING WELL: REHDER X6-13, 448'
- 4) IMPROVEMENTS: See LOCATION DRAWING for all visible improvements within 400' of disturbed area.
- 5) SURFACE USE: RANGELAND
- 6) INSTRUMENT OPERATOR: WYATT HALL

SURFACE LOCATION
 LATITUDE: 40.16317N
 LONGITUDE: 104.71273W
 PDP: 1.3
 ELEV: 4976'
 1/4, 1/4: SW1/4SW1/4
 NEAREST PROPERTY LINE: 252' N


BOTTOM HOLE
 LATITUDE: 40.16088N
 LONGITUDE: 104.70697W

NOTE
 According to Colorado law, you must commence any legal action based upon any defect in this W.L.C. within three years after you discover such defect. In no event, may any action based upon any defect in this survey be commenced more than ten years after the date of the certificate shown hereon. (13-80-105 C.R.S.)

LEGEND

-  = ALIQUOT MONUMENT AS DESCRIBED
-  = CALCULATED POSITION


Brian T. Brinkman—On behalf of Lat40°, Inc.
 Colorado Licensed Professional Land Surveyor No. 38175
 DATE: 1/13/12
 PROJECT#: 2011343

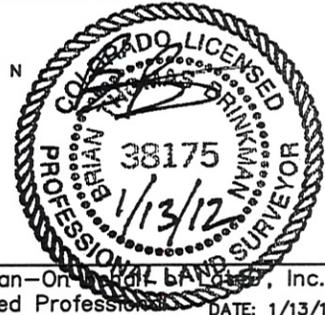

SITE SKETCH

THOMSEN USX X07-28D

SECTION: 6
TOWNSHIP: 2N
RANGE: 65W

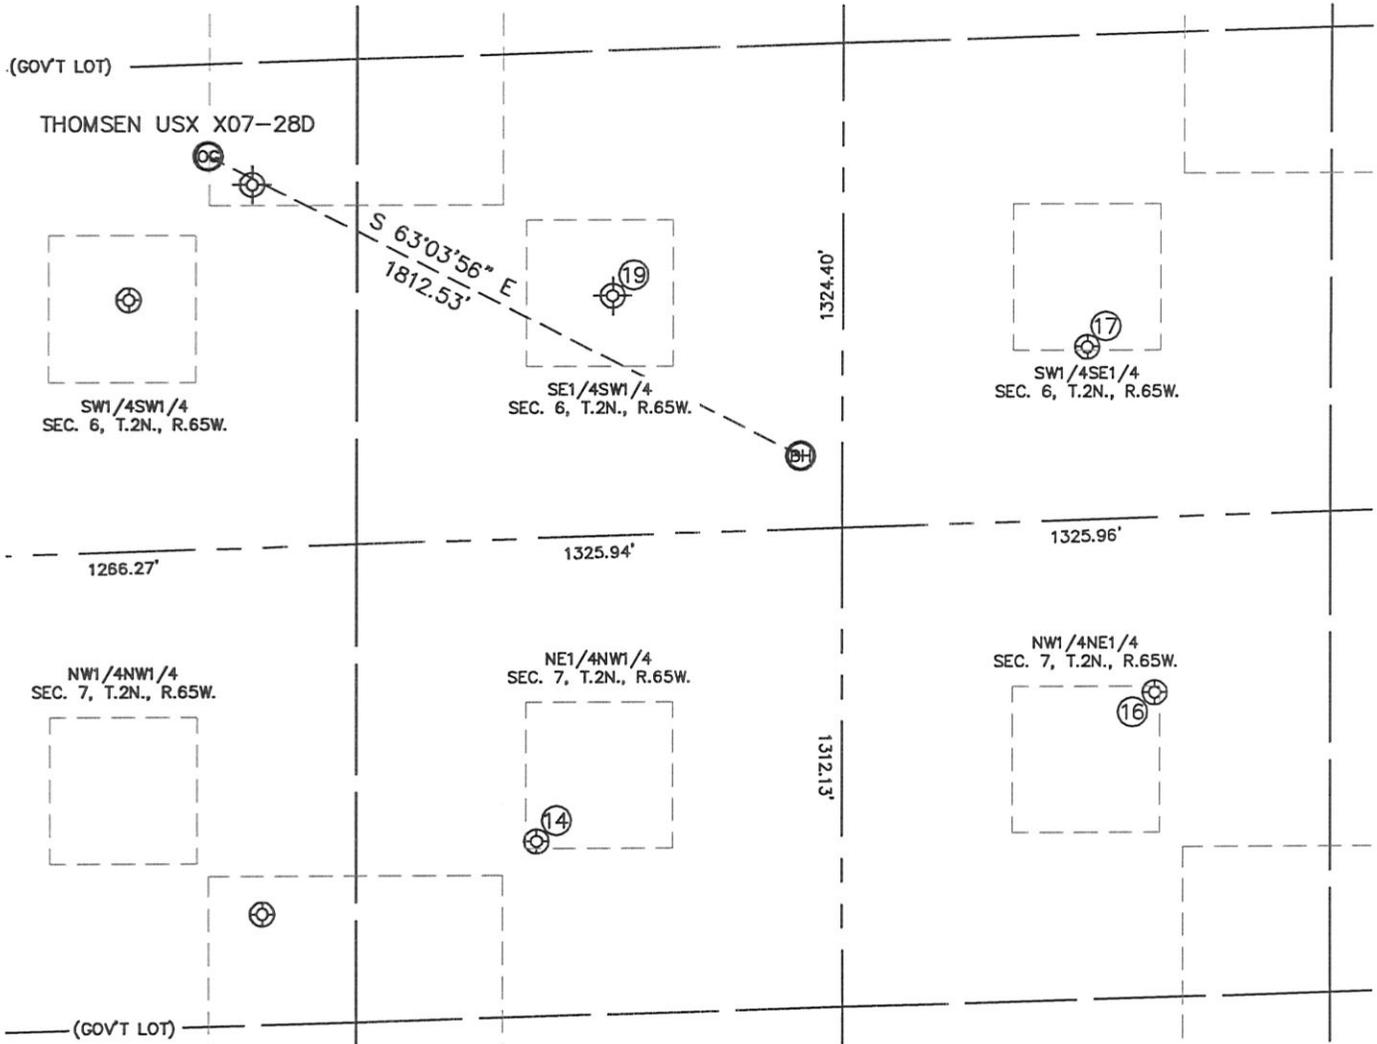

⑭
THOMSEN USX X7-3
NE1/4NW1/4
829' FNL
1754' FWL
LAT-40.15801°N
LONG-104.70958°W
PDOP: 1.5
ELEV: 4946'

⑯
THOMSEN 31-7
NW1/4NE1/4
480' FNL
1801' FEL
LAT-40.15907°N
LONG-104.70355°W
PDOP: 1.8
ELEV: 4923'

⑰
NICHOLS 15-6
SW1/4SE1/4
471' FSL
1987' FEL
LAT-40.16167°N
LONG-104.70418°W
PDOP: 1.7
ELEV: 4940'

⑱
REHDER X6-14
(PLUGGED & ABANDONED)
SE1/4SW1/4 (COGCC)
654' FSL (COGCC)
1970' FWL (COGCC)
LAT-40.161897°N (COGCC)
LONG-104.708868°W (COGCC)
PDOP: N/A
ELEV: 4952' (COGCC)

