


# WELL LOCATION CERTIFICATE

SECTION: 6  
TOWNSHIP: 6N  
RANGE: 62W

THIS MAP DOES NOT REPRESENT A BOUNDARY SURVEY

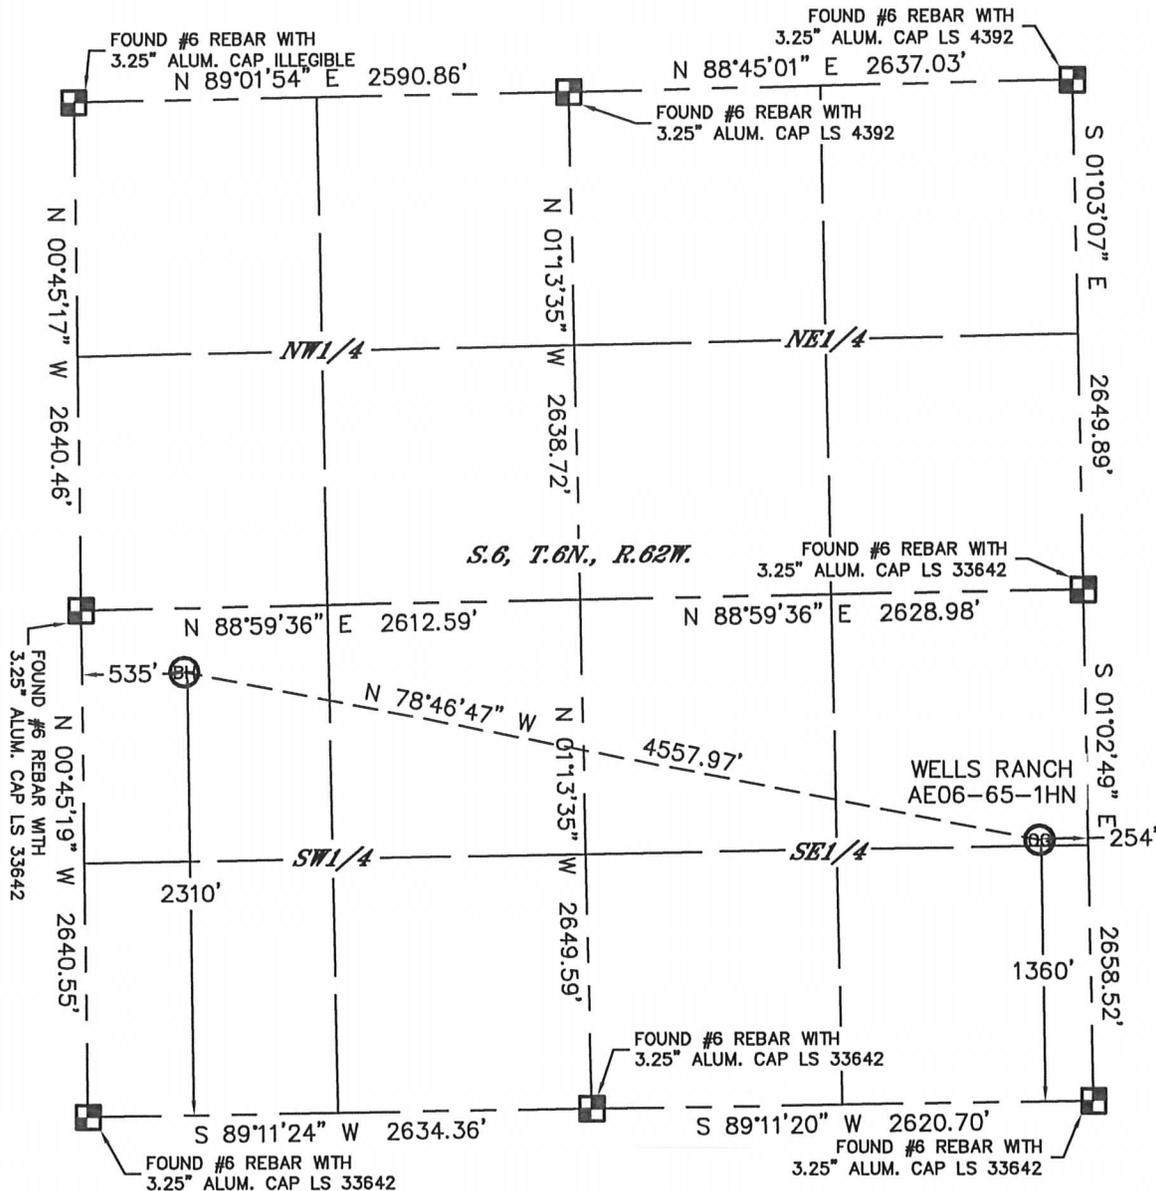

In accordance with a request from Sean Casper with Noble Energy Inc. Lat40°, Inc. has determined the surface location of the WELLS RANCH AE06-65-1HN to be 1360' from the SOUTH line and 254' from the EAST line and the bottom hole to be 2310' from the SOUTH line and 535' from the WEST line as measured at right angles from the section lines of Section 6, Township 6 North, Range 62 West of the Sixth Principal Meridian, County of Weld, State of Colorado.

I hereby state that this Well Location Certificate was prepared by me, or under my direct supervision, that the fieldwork was completed on 2/8/12, for and on behalf of Noble Energy Inc. That this is not a Land Survey Plat or an Improvement Survey Plat, and that it is not to be relied upon for establishment of fence, building, or other future Improvement lines.

**NOTE:**


- 1) Bearings shown are Grid Bearings of the Colorado State Plane Coordinate System, North Zone, North American Datum 1983/2007. The lineal dimensions as contained herein are based upon the "U.S. Survey Foot."
- 2) Ground elevations are based on an observed GPS elevation (NAVD 1988 DATUM).
- 3) NEAREST EXISTING WELL: (NONE WITHIN SECTION)
- 4) IMPROVEMENTS: See LOCATION DRAWING for all visible Improvements within 400' of disturbed area.
- 5) SURFACE USE: RANGELAND
- 6) INSTRUMENT OPERATOR: WYATT HALL

**SURFACE LOCATION**

LAT: 40.51215°N  
LONG: 104.35688°W  
PDOP: 1.9  
ELEV: 4944'  
1/4, 1/4: NE1/4SE1/4  
NEAREST PROPERTY LINE: 254' EAST

**BOTTOM HOLE**

LAT: 40.51474°N  
LONG: 104.37291°W

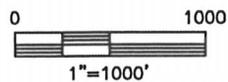

**LEGEND**

-  = ALIQUOT MONUMENT AS DESCRIBED
-  = CALCULATED POSITION

**NOTE**

According to Colorado law, you must commence any legal action based upon any defect in this W.L.C. within three years after you discover such defect. In no event, may any action based upon any defect in this survey be commenced more than ten years after the date of the certificate shown hereon. (13-80-105 C.R.S.)


Kyle E. Rutz—On behalf of Lat40° Inc.  
Colorado Licensed Professional Land Surveyor No. 38307  
DATE: 2/8/2012  
PROJECT#: 2012027



# SITE SKETCH

WELLS RANCH AE06-65-1HN

SECTION: 6  
TOWNSHIP: 6N  
RANGE: 62W

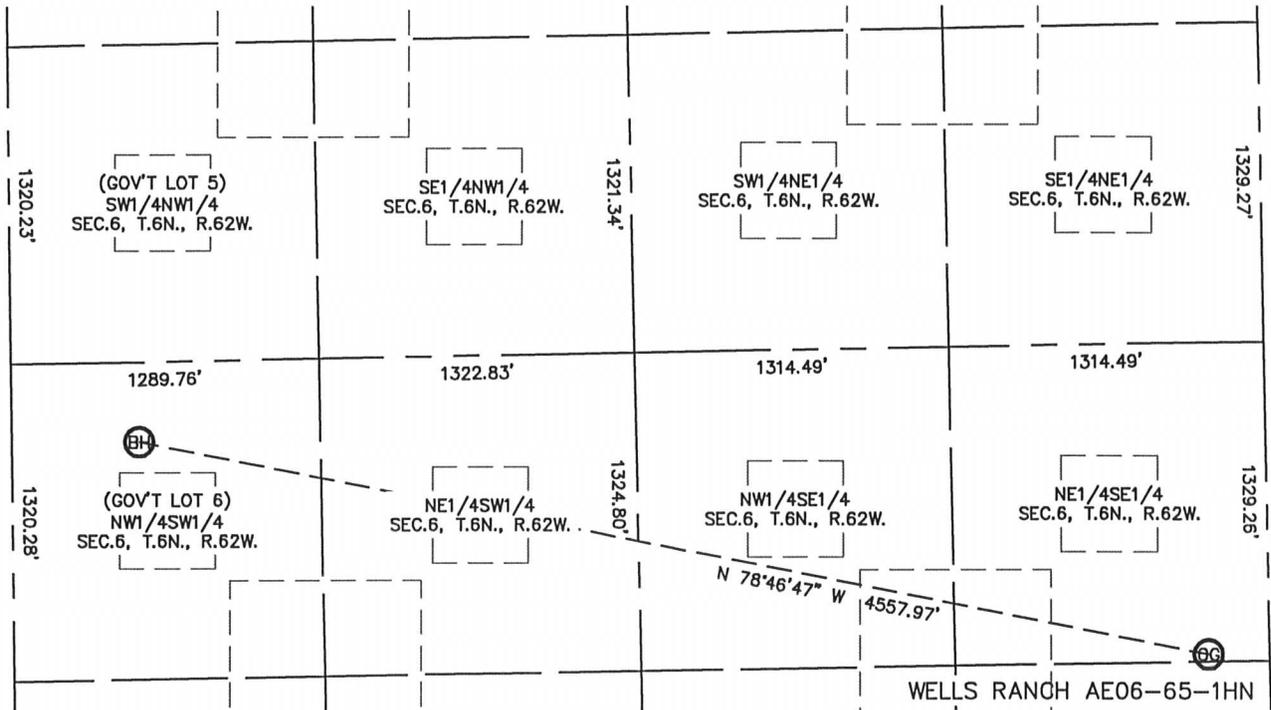

NOTE: NO EXISTING WELLS ALONG PROPOSED WELL BORE.

