Well Name:	**BBC 42B-23-692**	**BILL BARRETT CORPORATION**	
SHL:	SENE Sec. 23 T6S R92W 6th PM	date updated	**3/29/2012**
		updated by	**Megan Finnegan**

05-045-17689
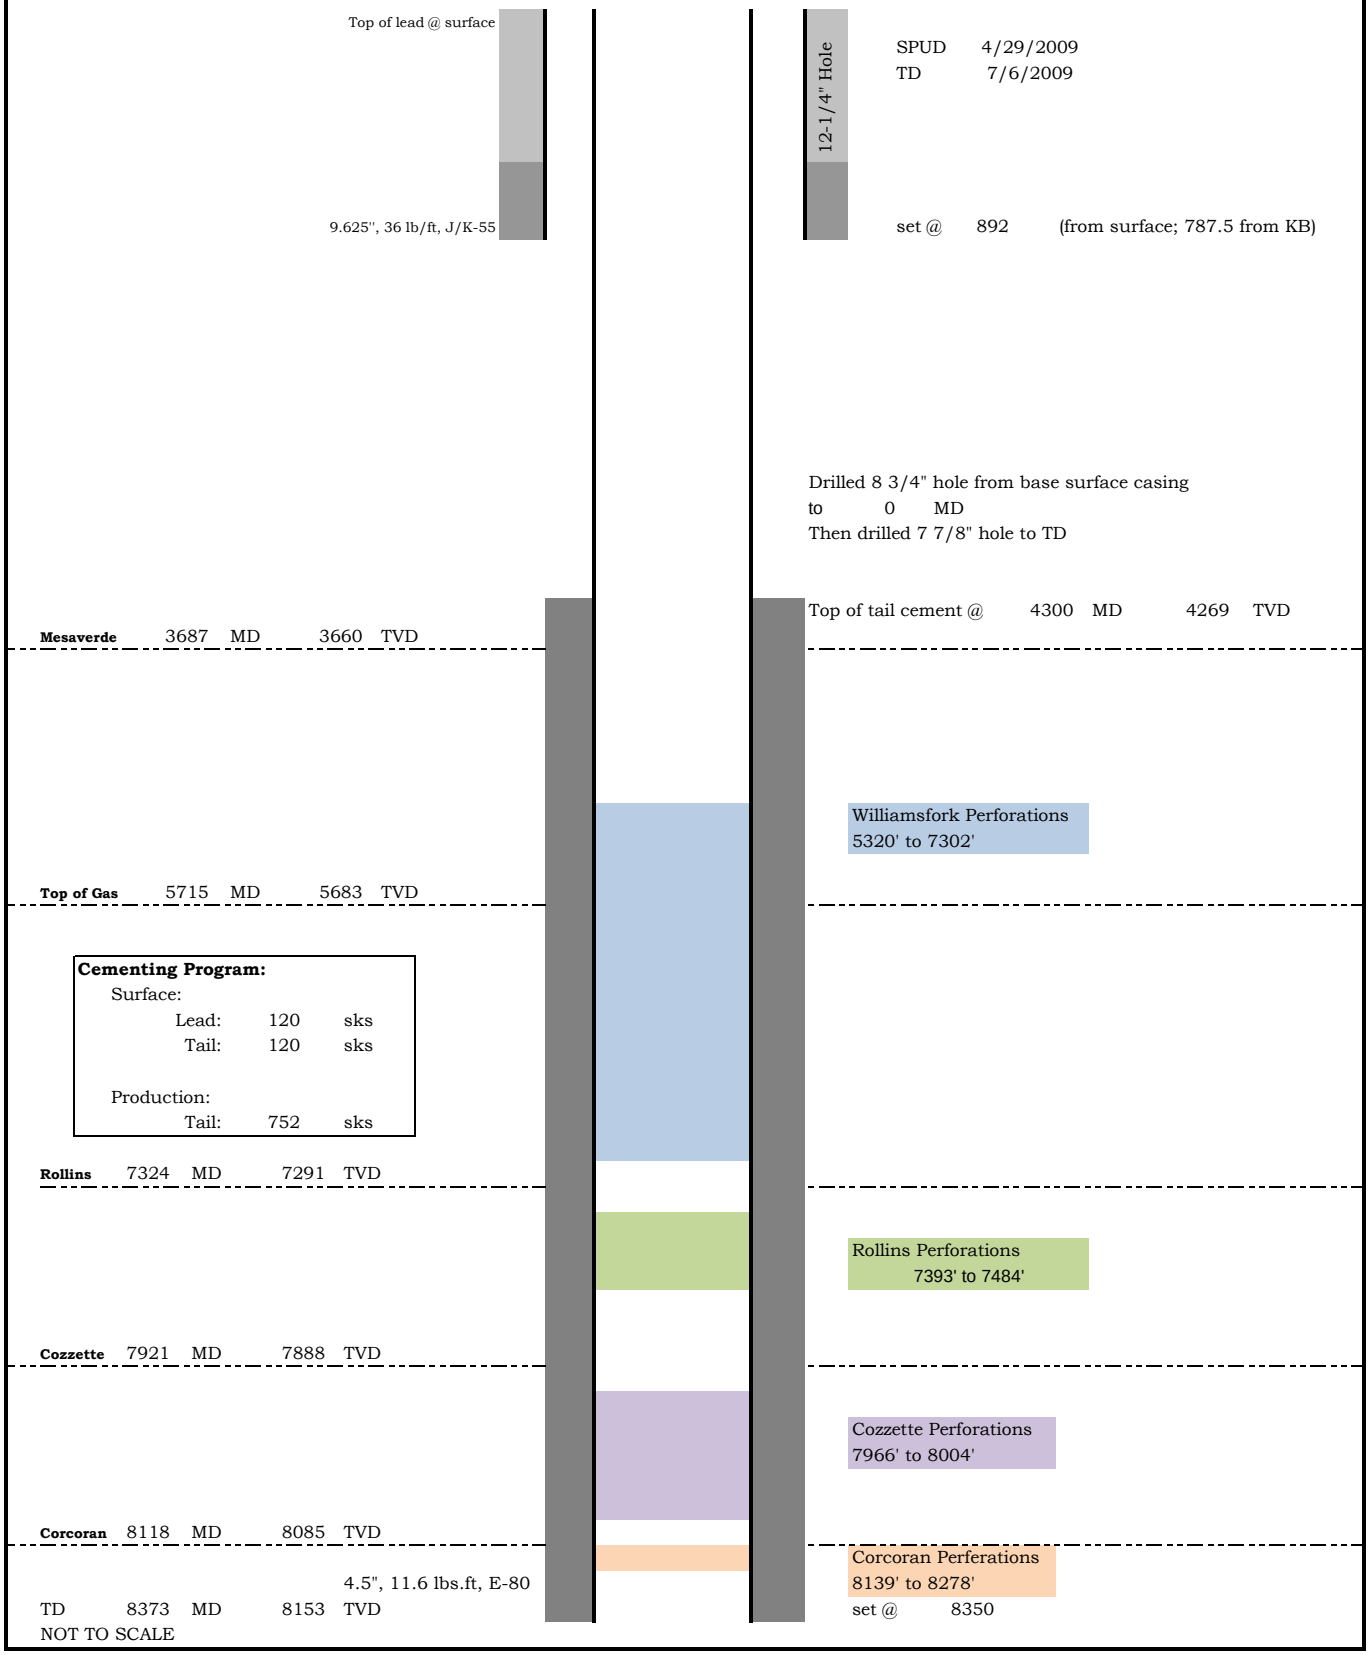
AS DRILLED