Well Name:	**Rothe 44-30**	**BILL BARRETT CORPORATION**	
SHL:	SESE Sec. 30 T5N R63W 6th PM	date updated	**4/17/2012**
		updated by	**Megan Finnegan**
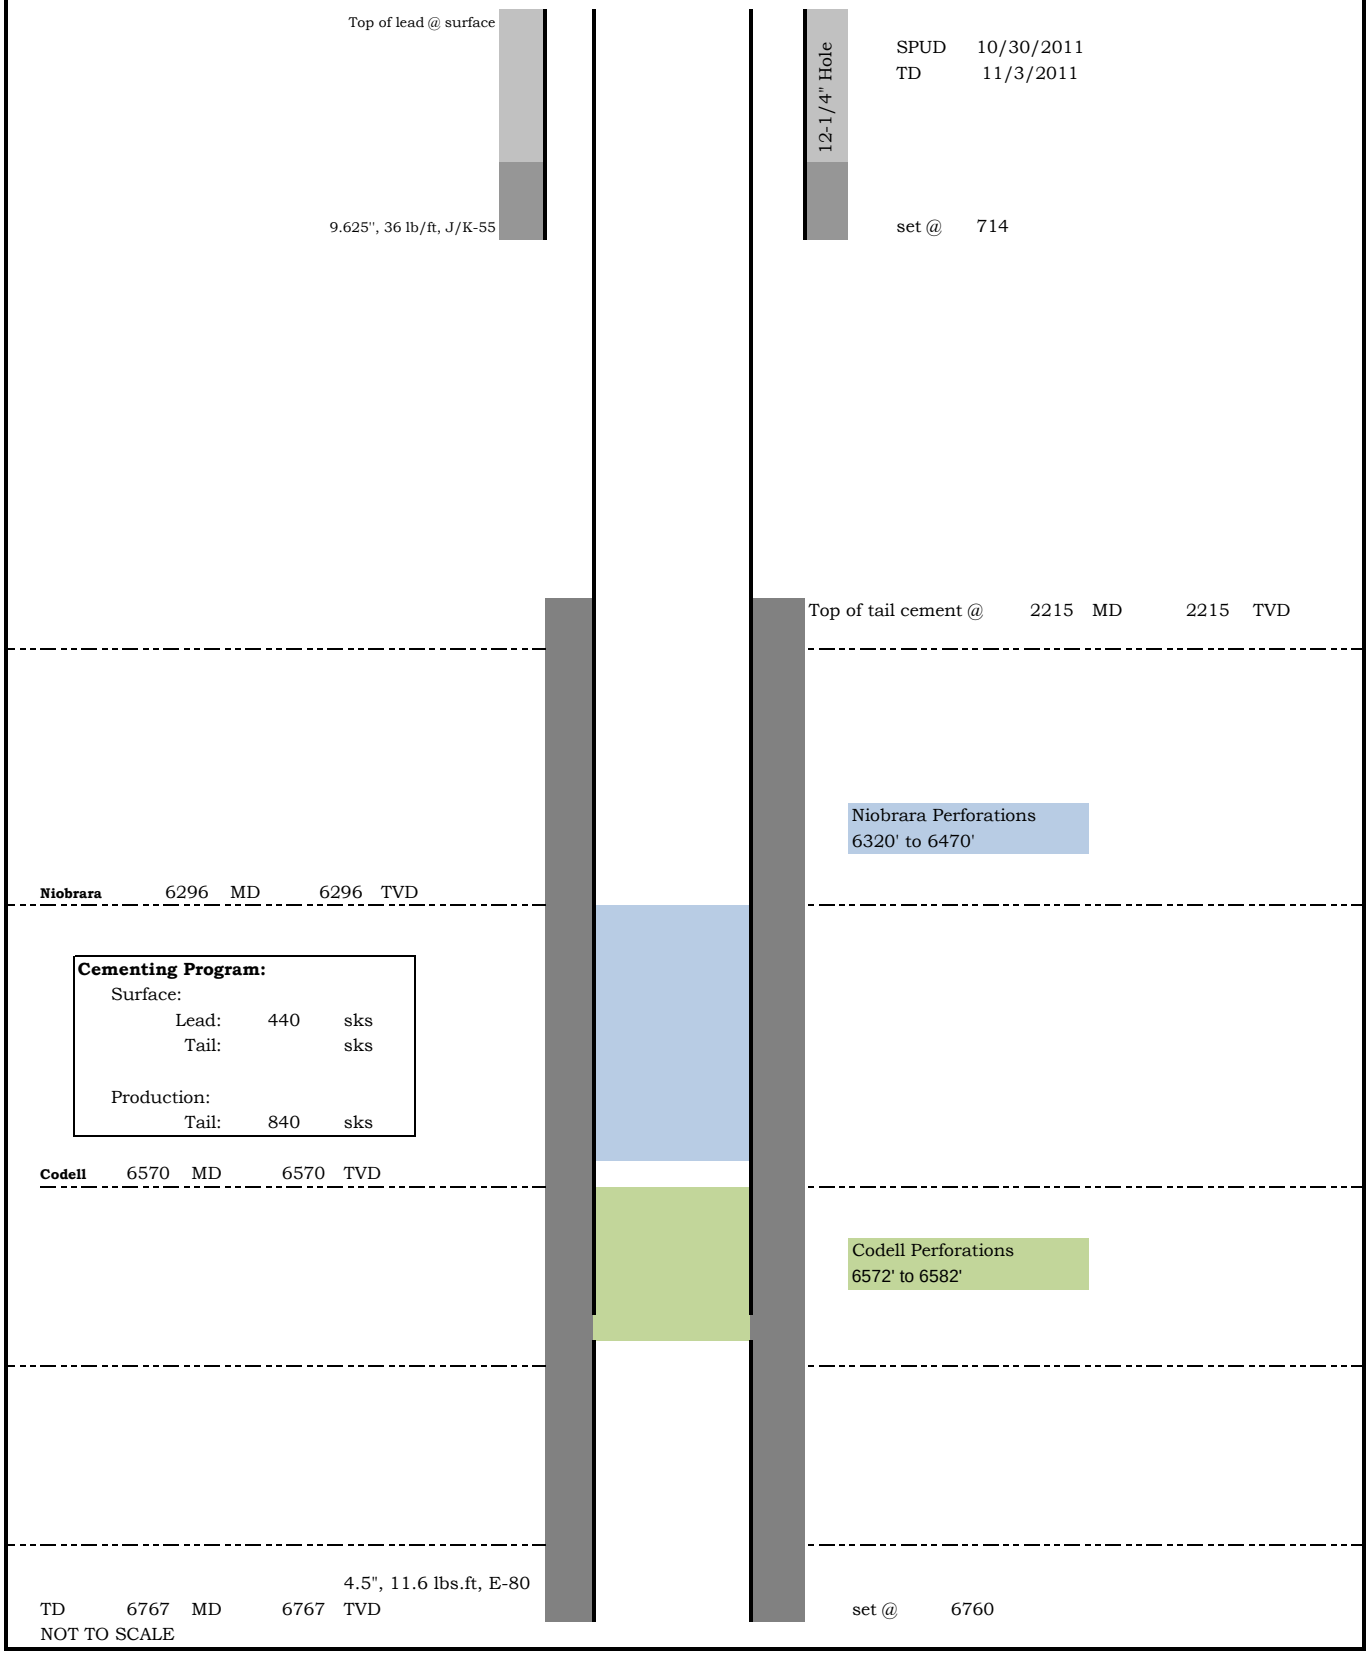
05-123-32101-00 AS DRILLED