


PLS Group, LLC  
 109 Coronado Ct. - Bldg. 7  
 Fort Collins, Colorado 80525  
 P. 970-282-3446 Fx. 970-377-6767

# WELL LOCATION CERTIFICATE

*THIS MAP DOES NOT REPRESENT A BOUNDARY SURVEY*

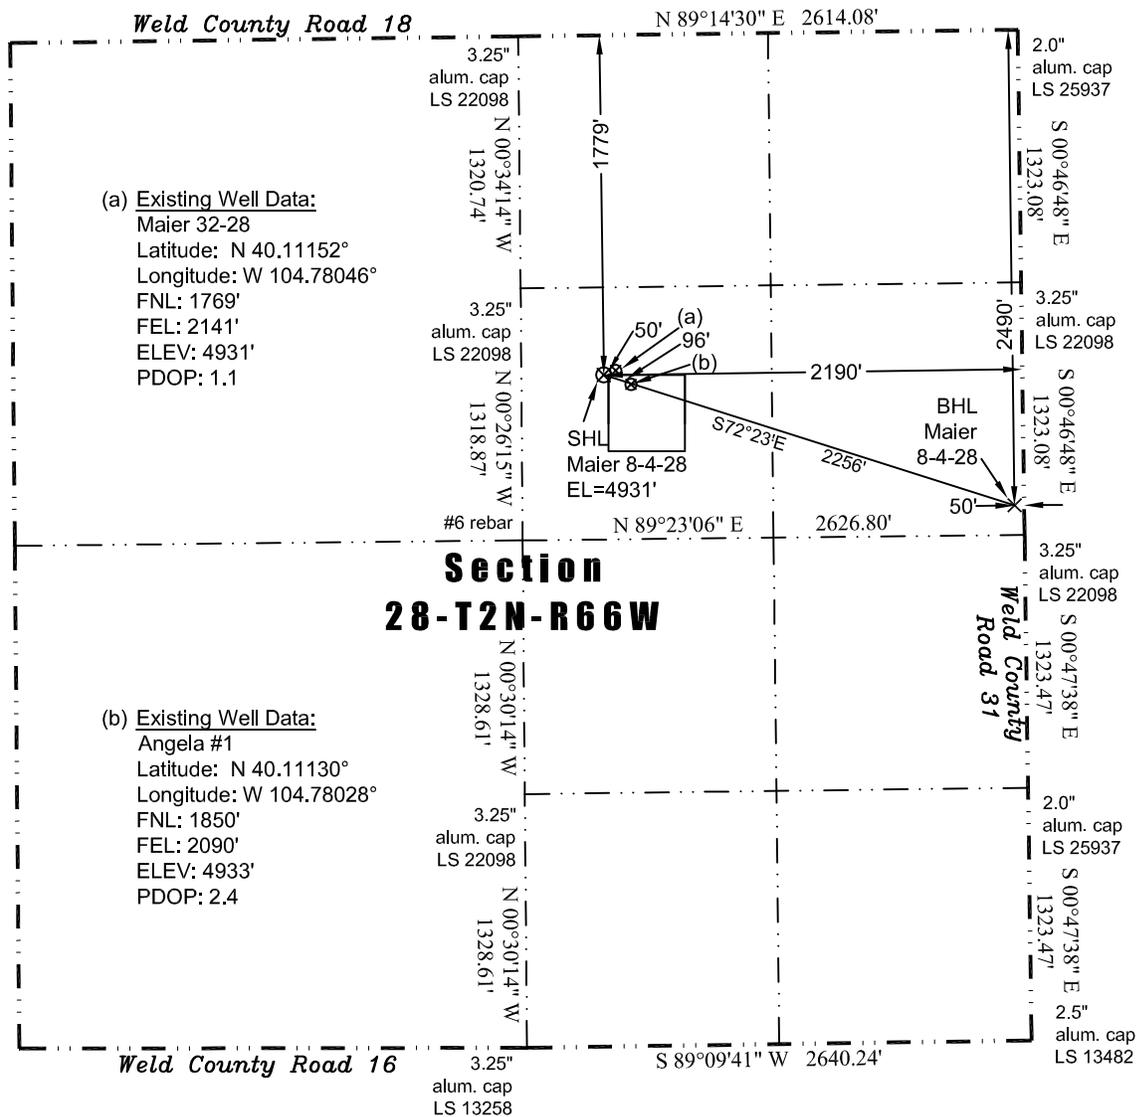

(a) Existing Well Data:  
 Maier 32-28  
 Latitude: N 40.11152°  
 Longitude: W 104.78046°  
 FNL: 1769'  
 FEL: 2141'  
 ELEV: 4931'  
 PDOP: 1.1

(b) Existing Well Data:  
 Angela #1  
 Latitude: N 40.11130°  
 Longitude: W 104.78028°  
 FNL: 1850'  
 FEL: 2090'  
 ELEV: 4933'  
 PDOP: 2.4

## Section 28-T2N-R66W

Scale 1" = 1000'

approximate scale

LEGEND  
 — found survey monument  
 - - - calculated dimension

(c)

In accordance with a request from Jay Knutson of EnCana Oil & Gas (USA) Inc., PLS Group, LLC has determined the location of the **Maier 8-4-28** well site to be SHL: 1779' FNL and 2190' FEL, (BHL 2490' FNL and 50' FEL), as measured at ninety (90) degrees from the section lines of Section 28, Township 2 North, Range 66 West of the 6th Principal Meridian, Weld County Colorado.

Proposed Surface Hole Data:  
 Latitude: N 40.11150° (BHL: 40.10958°)  
 Longitude: W 104.78064° (BHL: 104.77297°)  
 PDOP: 1.1

Nearest:  
 Building 1,136' southwest      Above Ground Utility 2,010' east  
 Public Road 2,170' east      Railroad 7,768' west  
 Property Line 432' west      Well Window: SHL is 25' outside  
 Existing Well: Maier 32-28 50' northeast

- Notes:
- 1) Bearings and distances based on NAD 83 Colorado North State Plane Coordinates using RTK GPS observations taken 7/17/11 by operator Tom Winans.
  - 2) Conversion factor to ground (1.000274424).
  - 3) Elevations based on NAVD 88 GPS heights and Geoid 2003 corrections.
  - 4) See Location Drawing for visible improvements within 400 feet of Pad Site.
  - 5) The surface use is cultivated field.

**NOTICE:** According to Colorado law you must commence any legal action based upon any defect in this W.L.C. within three years after you first discover such defect. In no event may any action based upon any defect in this W.L.C. be commenced more than ten years from this said date of the certification shown hereon.

I hereby certify that this Well Location Certificate was prepared by me or under my direct supervision and for and on behalf of EnCana Oil & Gas (USA) Inc. That I am a Land Surveyor in an Improvement Survey Plat and that it is not to be relied upon for establishment of fence, buildings, or other future improvement lines.

John Robert McGehee LS#38219  
 Well: Maier 8-4-28 WLC