


Rosewood Resources, Inc
Arledge 2-25
Sample Plan

X
Background
Sample

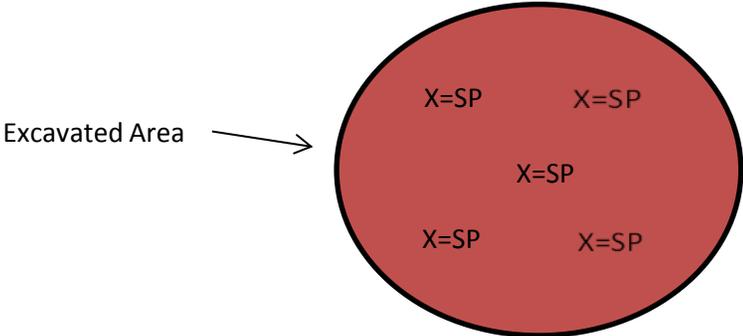

Arledge 2-25
NWNW Sec. 25
T4N-R47W
Yuma County, CO
API # -05-125-08474

Legend:
X=Sample Point (SP)
(Map Not To Scale)