




Lease Name: Cletcher #11-21D

Legals: SENW – Sec. 21, T4N, R68W

County: Weld County, Colorado

API#: 05-123-30466

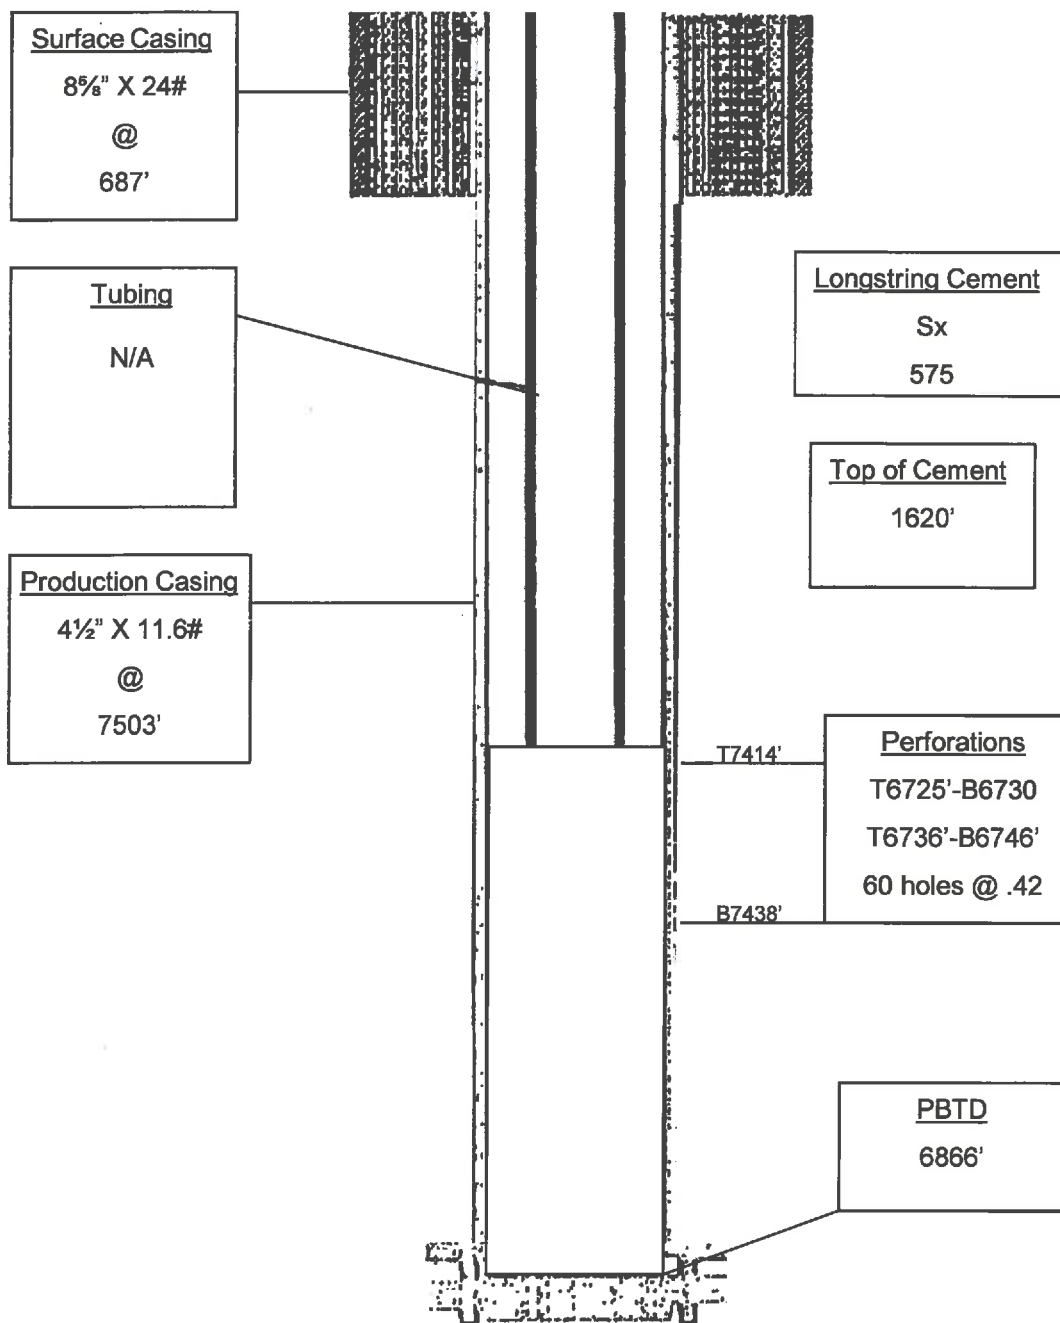

Wellbore Diagram