




Lease Name: Haythorn #32-36D

Legals: NENE – Sec. 36, T7N, R66W

County: Weld County, Colorado

API#: 05-123-33827

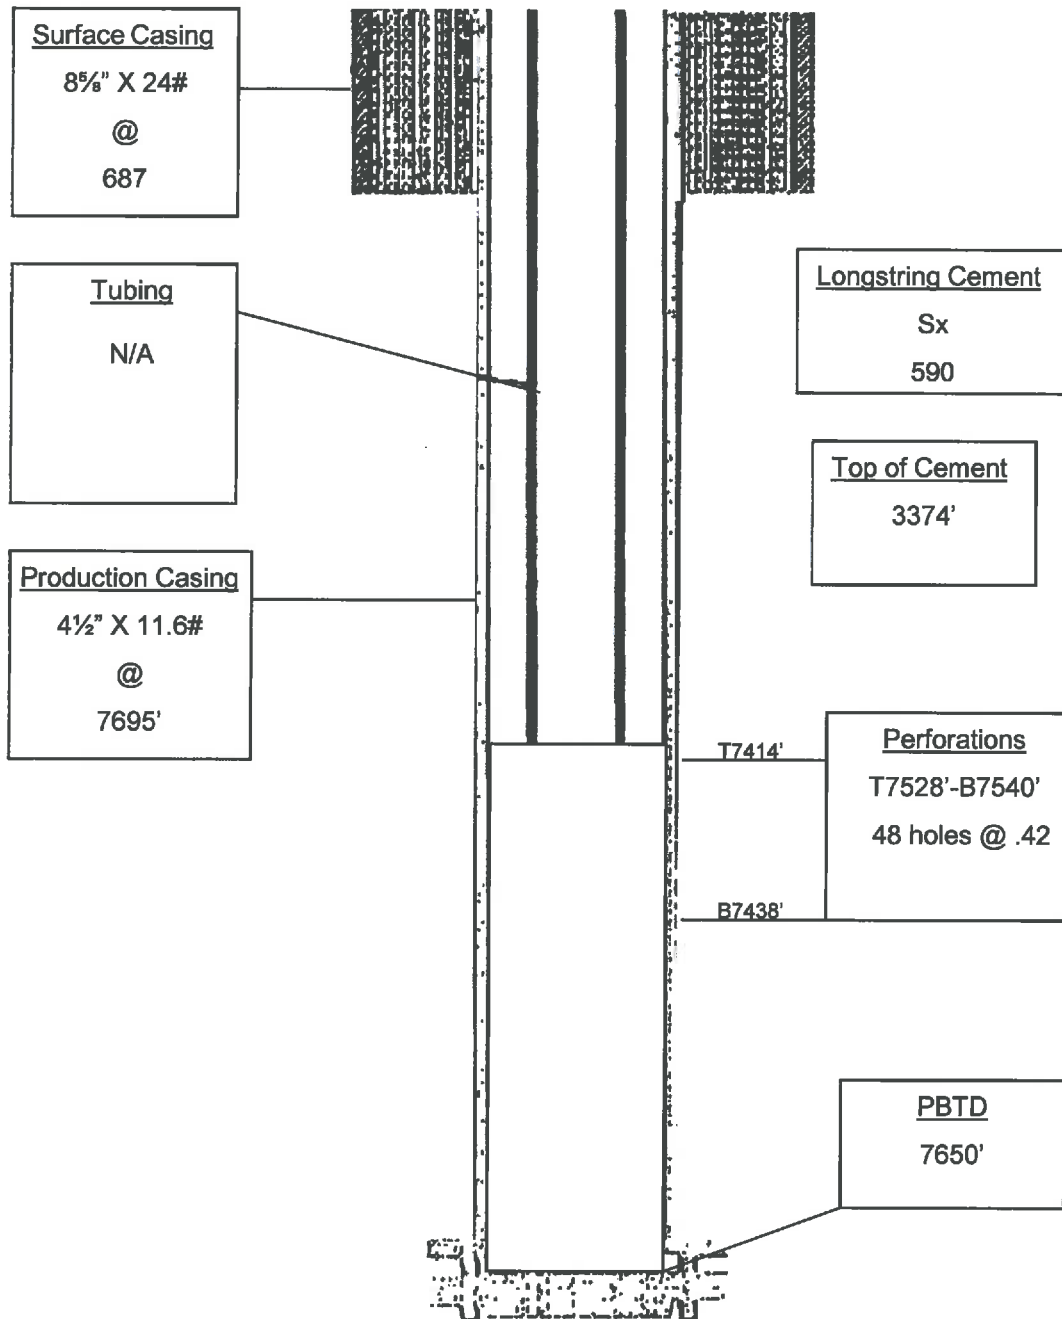

Wellbore Diagram