




Lease Name: Leffler #14-26D

Legals: NWSW – Sec. 26, T7N, R66W

County: Weld County, Colorado

API#: 05-123-34267

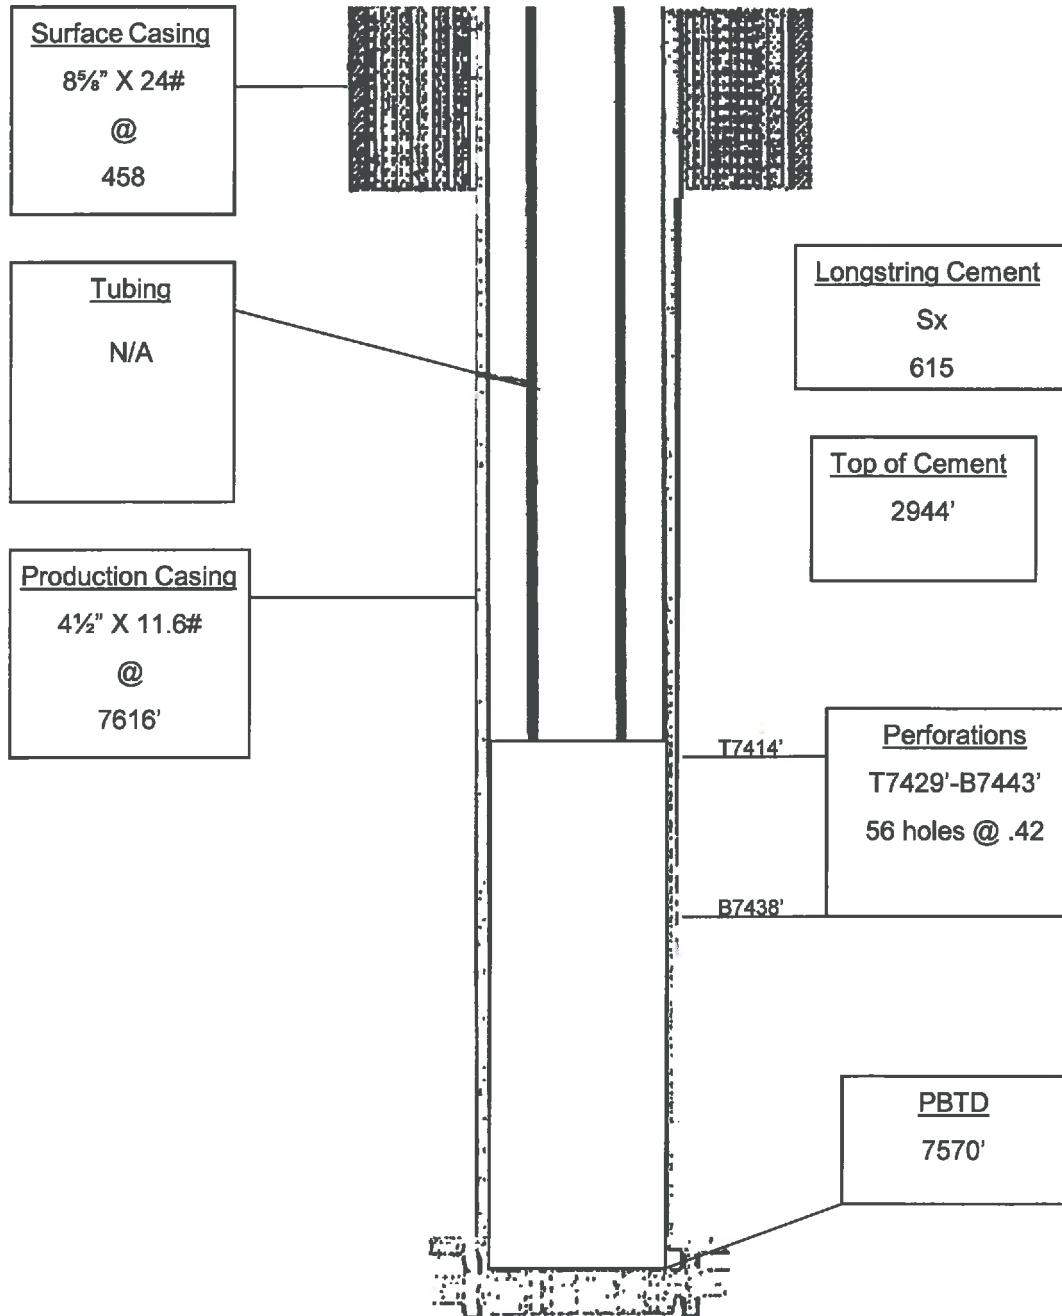

Wellbore Diagram