


MARATHON OIL CO. OWL CREEK 8-64-30-1H AS-DRILLED WELL LOCATION PLAT

LOCATED WITHIN LOT 1 OF SECTION 30, T8N, R64W,

OF THE 6TH P.M., WELD COUNTY, COLORADO

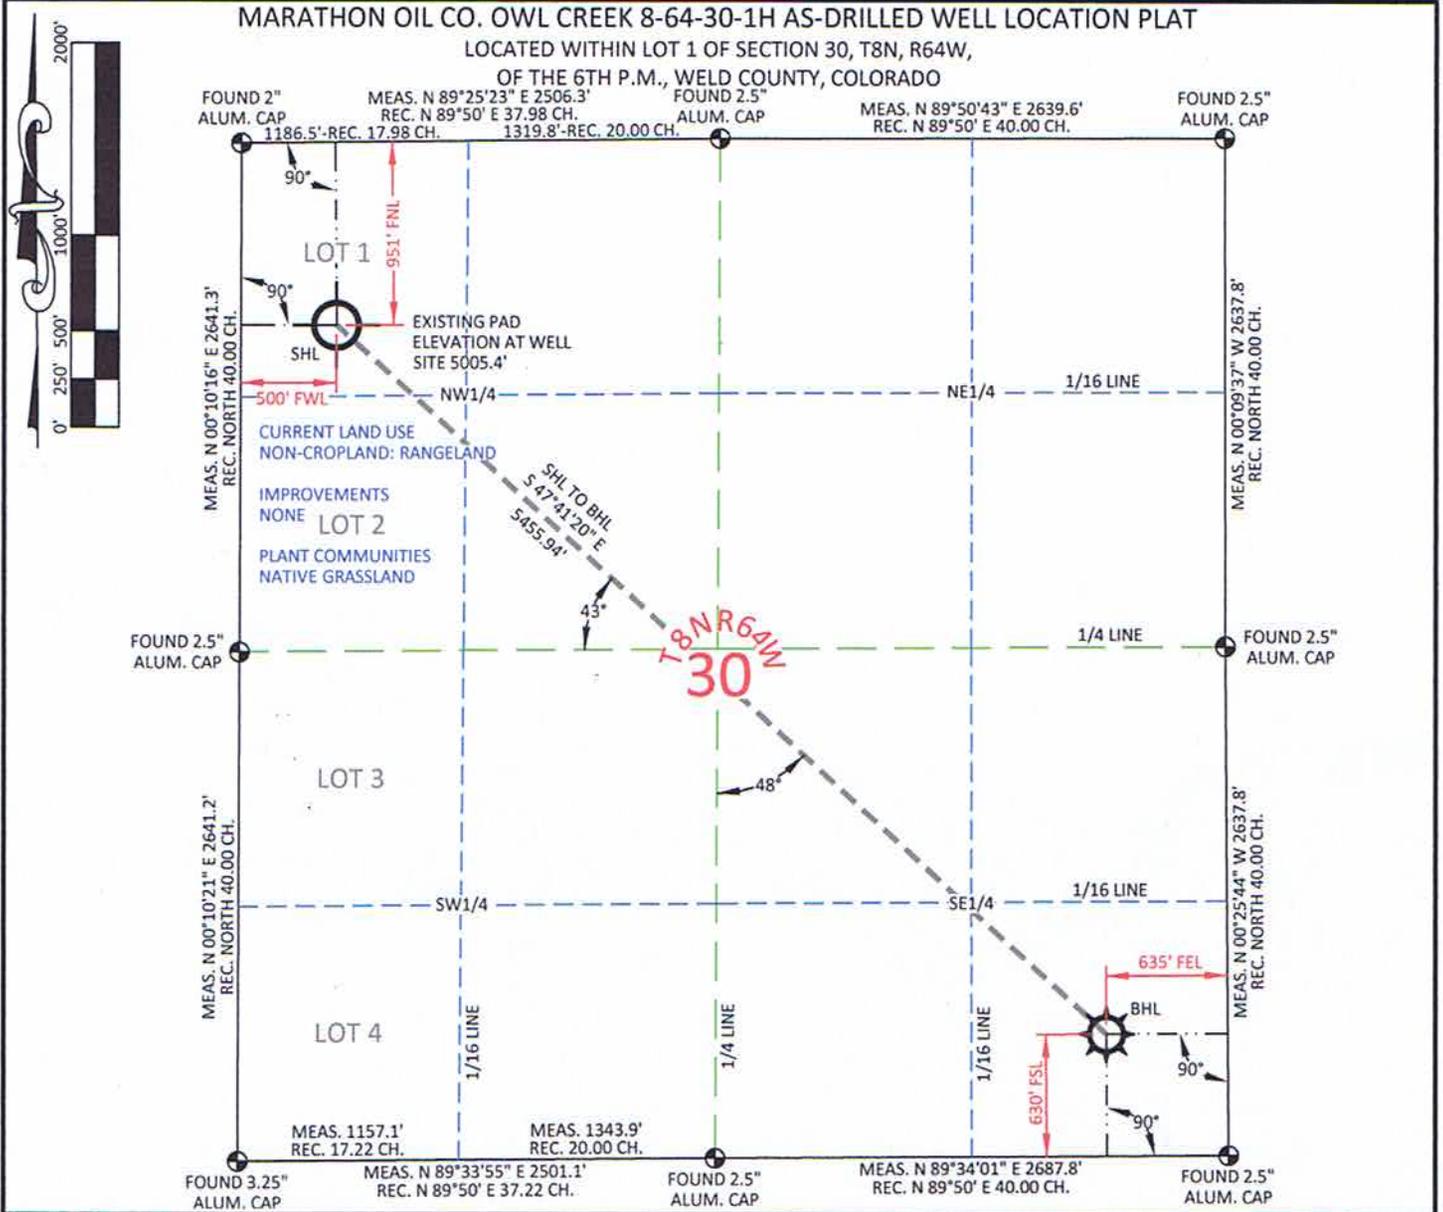

SURFACE HOLE (AS-DRILLED)	
LAT.	40.635535°
LONG.	104.599613°
LAT.	40.635554°
LONG.	104.599097°
LAT.	40°38'07.93"
LONG.	104°35'58.61"
LAT.	40°38'07.99"
LONG.	104°35'56.75"
NORTH	1475636.13
EAST	3249891.59
NORTH	475636.20
EAST	2250041.47
FOOTAGE: 500' FWL - 951' FNL	
MEASURE DATE	12/12/2011
INSTRUMENT OPERATOR	ALLEN BLATTEL
PDOP	3.9
SHL GRND ELEV.	5005.4'

BOTTOM HOLE (AS-DRILLED)	
LAT.	40.625341°
LONG.	104.585213°
LAT.	40.625360°
LONG.	104.584697°
LAT.	40°37'31.23"
LONG.	104°35'06.77"
LAT.	40°37'31.30"
LONG.	104°35'04.91"
NORTH	1471963.44
EAST	3253926.26
NORTH	471963.59
EAST	2254076.06
FOOTAGE: 635' FEL - 630' FSL	

I, Rodney A. Walters, Professional Land Surveyor, CO. LS #16847 hereby certify that (in accordance with a request from Erin Bibeau with Marathon Oil Co, 5555 San Felipe, Houston, TX 77056) I and/or personnel under my direction made a survey on the 12th day of December 2011, for the Surface Hole Location and Elevation of Marathon Oil Co. OWL CREEK 8-64-30-1H being located within Lot 1, Section 30, T8N, R64W, and the Bottom Hole Location being located in the SE1/4 SE1/4 of Section 30, T8N, R64W, both being of the 6th P.M., Weld County, State of Colorado.

- All bearings and distances are GRID, based on the Colorado State Plane Coordinate System, North Zone, North American Datum 1983 from GPS observations occupying a WHS control point (5/8" rebar) and having the Location and Elevation derived from an Opus Solution.
- Vertical Datum used is of NAVD 88.
- Record Bearings and Distances as shown are based on the General Land Office Survey plat approved on the 20th day of October 1870.
- Geographic coordinates for the bottom hole location were taken from the wellplat report prepared by Baker Hughes for Owl Creek 8-64-30-1H and dated 12/20/2011.



CONFIDENTIALITY NOTES:
The information contained in this plat is legally privileged and confidential information intended only for the use of the recipients. If you are not the intended recipients, you are hereby notified that any use, dissemination, distribution or copying of this information is strictly prohibited.

WILLIAM H. SMITH & ASSOCIATES P.C.
SURVEYING CONSULTANTS
550 EAST SECOND NORTH GREEN RIVER, WY
PHONE: 307-875-3638
307-875-3639
www.whsmithpc.com

DRAWN BY: LAL
PROJECT NO: 864301H
REVISIONS:

CHECKED BY: RAW
JOB NO: 2011001

LEGEND

- ⊕ FOUND CORNER
- ⊗ CALCULATED CORNER
- NOTHING FOUND

LOCATION:
OWL CREEK
8-64-30-1H
WITHIN LOT 1 OF
SECTION 30,
T 8 N, R 64 W,
6TH PM.
WELD COUNTY,
COLORADO

MARATHON OIL COMPANY
PO BOX 3128, HOUSTON TX, 77253
5555 SAN FELIPE, HOUSTON TX, 77056

AS-DRILLED WELL LOCATION PLAT

SCALE: 1"=1000'
DATE: 04/27/2012

EXHIBIT "A"
SHEET 1 OF 1