




Lease Name: Margil #34BD

Legals: NWSW – Sec. 34, T4N, R68W

County: Weld County, Colorado

API#: 05-123-34122

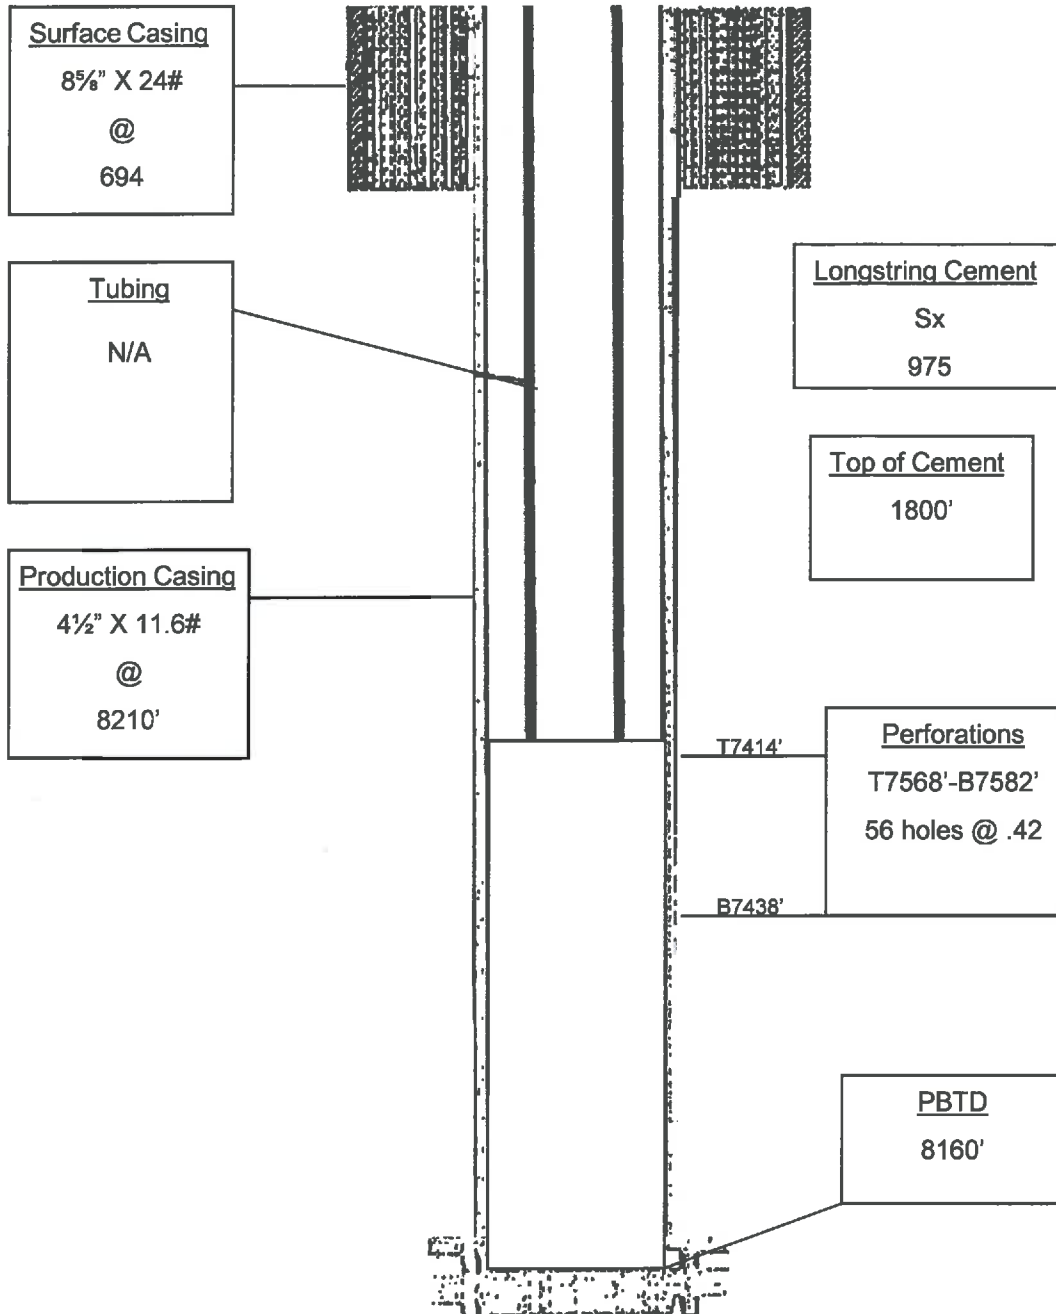

Wellbore Diagram