




Lease Name: Margil # 24-34D

Legals: SESW – Sec. 34, T4N, R68W

County: Weld County, Colorado

API#: 05-123-34125

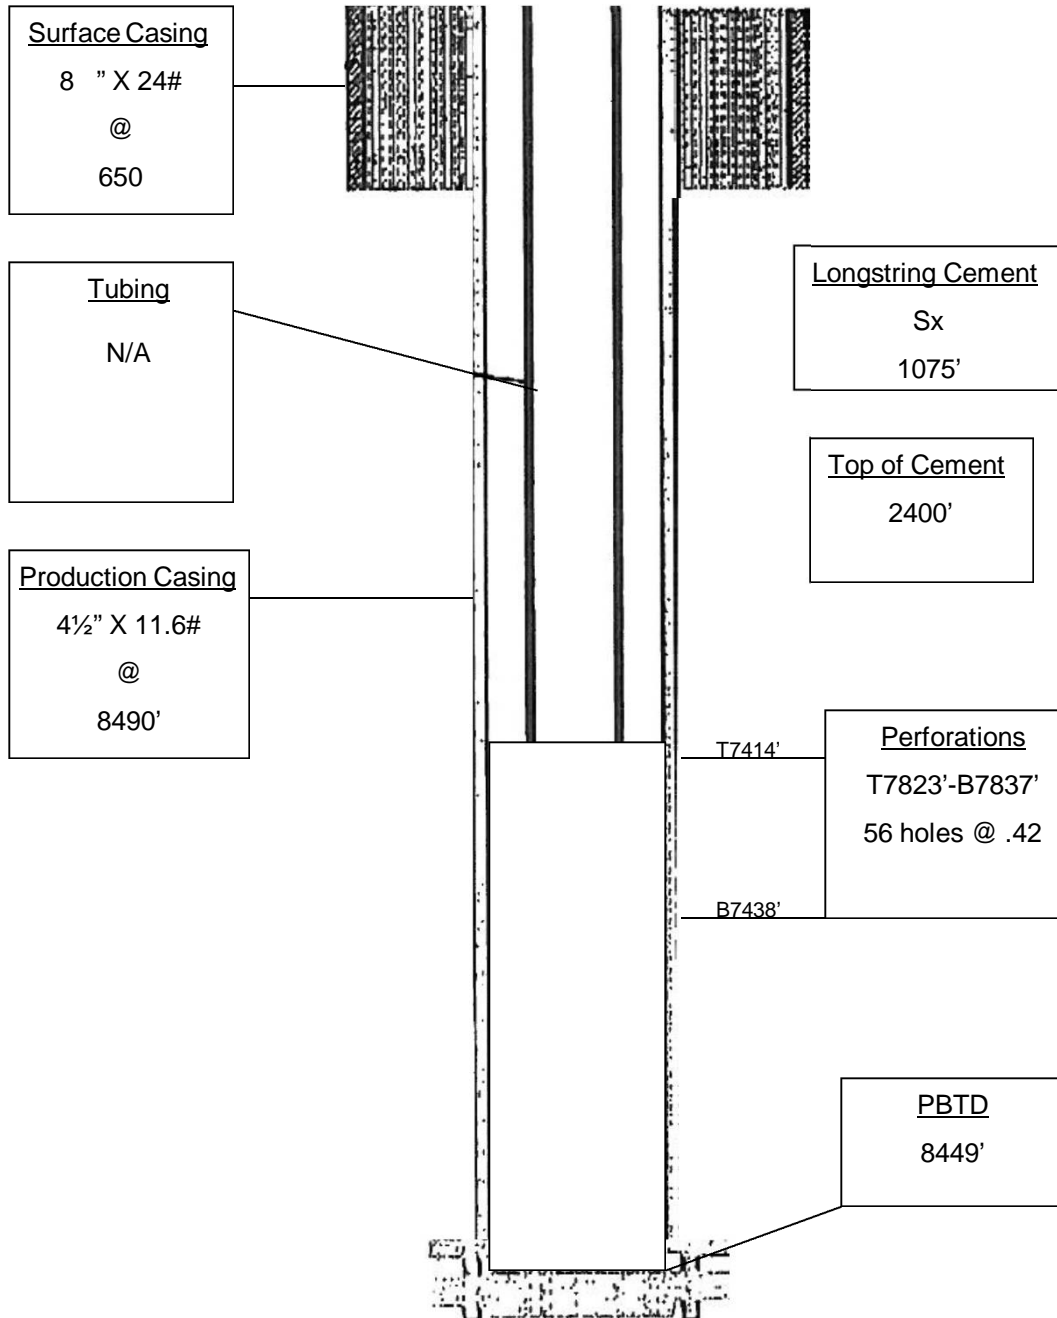

Wellbore Diagram