PROPOSED SPACING UNIT - NOBLE ENERGY INC.

Lat40°, Inc. 1635 Foxtrail Drive, Suite 325 Loveland, CO 970-776-3321

WELL LOCATION CERTIFICATE

THIS MAP DOES NOT REPRESENT A BOUNDARY SURVEY

SECTION: 12
TOWNSHIP: 6N
RANGE: 63W

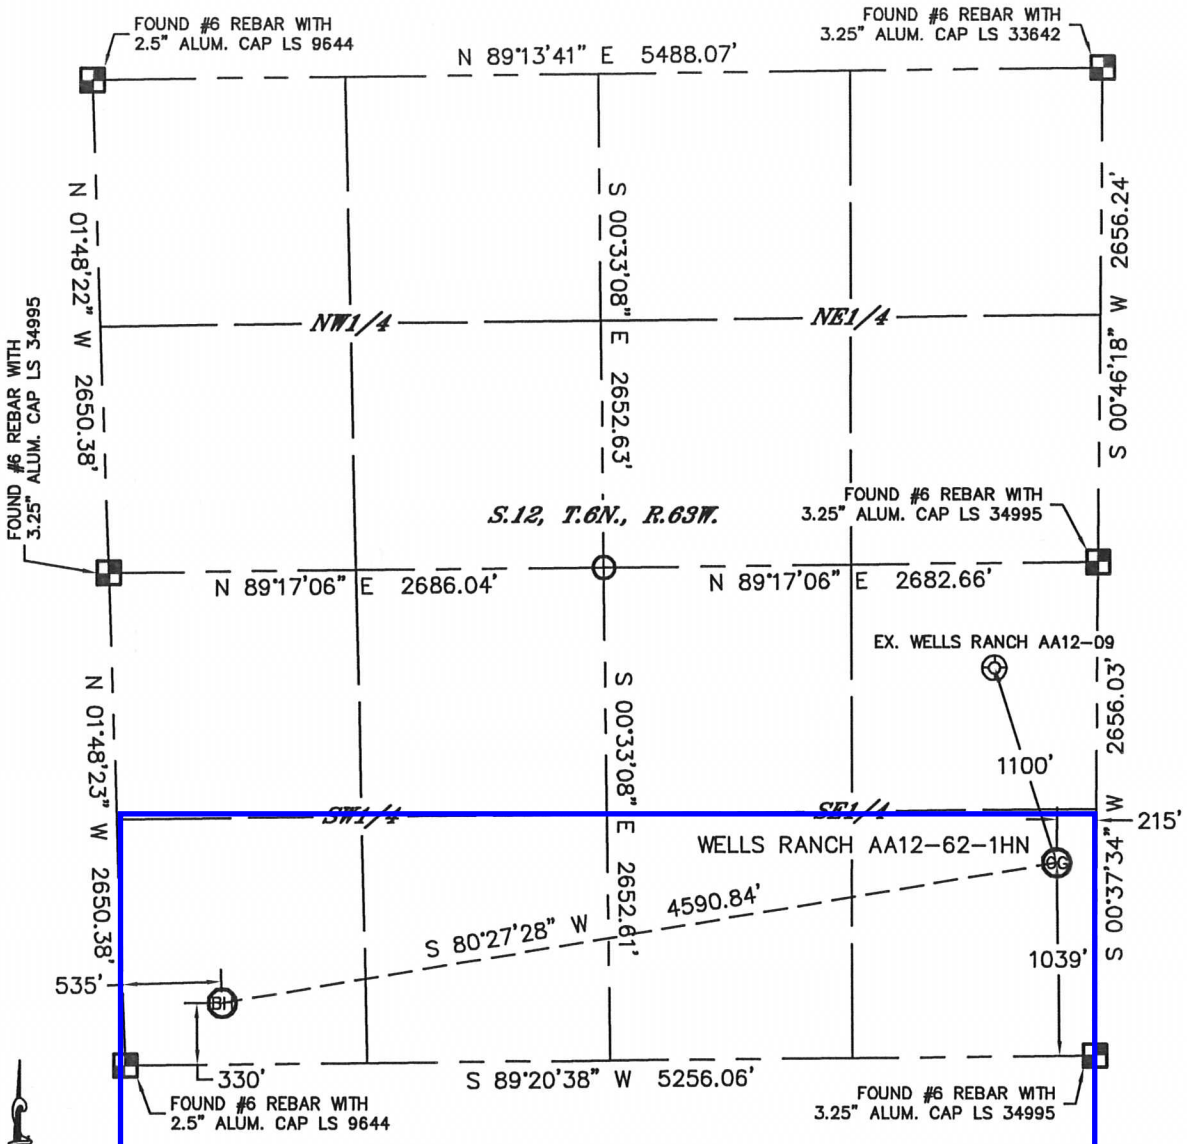

In accordance with a request from Sean Casper with Noble Energy Inc. Lat40°, Inc. has determined the surface location of the WELLS RANCH AA12-62-1HN to be 1039' from the SOUTH line and 215' from the EAST line and the bottom hole to be 330' from the SOUTH line and 535' from the WEST line as measured at right angles from the section lines of Section 12, Township 6 North, Range 63 West of the Sixth Principal Meridian, County of Weld, State of Colorado.

I hereby state that this Well Location Certificate was prepared by me, or under my direct supervision, that the fieldwork was completed on 2/16/2012, for and on behalf of Noble Energy Inc. That this is not a Land Survey Plat or an Improvement Survey Plat, and that it is not to be relied upon for establishment of fence, building, or other future improvement lines.

NOTE:
1) Bearings shown are Grid Bearings of the Colorado State Plane Coordinate System, North Zone, North American Datum 1983/2007. The lineal dimensions as contained herein are based upon the "U.S. Survey Foot."
2) Ground elevations are based on an observed GPS elevation (NAVD 1988 DATUM).
3) NEAREST EXISTING WELL: WELLS RANCH AA12-09, 1100'
4) IMPROVEMENTS: See LOCATION DRAWING for all visible improvements within 400' of disturbed area.
5) SURFACE USE: RANGELAND
6) INSTRUMENT OPERATOR: ADAM KELLY

SURFACE LOCATION
LAT: 40.49668°N
LONG: 104.37599°W
PDOP: 1.1
ELEV: 4857'
1/4,1/4: SE1/4SE1/4
NEAREST PROPERTY LINE: 215' E

BOTTOM HOLE
LAT: 40.49475°N
LONG: 104.39230°W

NOTE
According to Colorado law, you must commence any legal action based upon any defect in this W.L.C. within three years after you discover such defect. In no event, may any action based upon any defect in this survey be commenced more than ten years after the date of the certificate shown hereon. (13-80-105 C.R.S.)

LEGEND
= ALIQUOT MONUMENT AS DESCRIBED
= CALCULATED POSITION

COLORADO LICENSED BRIAN T. BRINKMAN 38175 PROFESSIONAL LAND SURVEYOR 2/21/12

Brian T. Brinkman-On behalf of Lat40°, Inc.
Colorado Licensed Professional
Land Surveyor No. 38175

DATE: 2/20/2012
PROJECT#: 2011002