



District Office
3801 Carson Avenue
Evans, CO 80620
970-506-9272
www.petd.com

COPY

March 12, 2012

Rite A Way Industries
c/o Josh O-Dean
24850 WCR 15.25
Johnstown, CO 80543

VIA Hand Delivery

Received by: Josh O-Dean

Date: 3/20/12

Notice of Drilling Operations, ~~32J-203~~, ~~32E-323~~, ~~32E-223~~, 32M-243, ^{32J-103}
Well Name: Riteaway ~~32J-203~~, 32J-403,
~~32E-323~~ ~~32E-223~~, 32M-243
Township 5 North, Range 67 West, 6th P.M.
Section 32: NENW (Surface Hole Location)
Section 32: SW/4 (Bottom hole Locations)
Weld County, Colorado

Gentlemen:

In accordance with the requirement of Rule 305.e.(1).B. of the Colorado Oil and Gas Conservation Commission (COGCC), this letter serves as a 30-day notice by Petroleum Development Corporation dba PDC Energy (PDC), as operator of record, of its intention to conduct drilling operations on the captioned wells.

Reference is made to the meeting we had on site on March 1, 2012 as well as additional discussions since then, when we discussed the location of the well sites, access roads, production facilities and other related matters. For the purposes of having our Initial Consultation, the March 1, 2012 shall be considered as that meeting. The well locations have been be staked and I have attached a copy. Pursuant to Rule 306, would you please complete the enclosed postage prepaid postcard to request a consultation or to designate a representative for surface consultation for our records, even though the consultation has been done? Also enclosed is a site diagram that depicts the area, per COGCC rules, within which the well(s) may be located, and the proposed location of the well(s), access road(s), and production facilities. Additionally, enclosed please find a copy of the COGCC's brochure describing surface owner rights and responsibilities, and a copy of the COGCC's on-site inspection policy.

I have also enclosed a Waiver Letter (related to the well locations) that is required to be signed and attached to PDC's drilling permit application with the COGCC. It is requested that you sign and return this Waiver. As surface owner you have the responsibility for notifying any affected tenant farmer, lessee or other party that may own or have an interest in any crops or surface improvements that could be affected by these proposed operations. Should you have any questions regarding our operations or this notice, please feel free to contact me at contact me at (303) 517-3010.


Sincerely,
PDC Energy

Mac Neumann, Agent

cc: Carrie Eggleston
John Krattenmaker

32E-323 32J-103

Attached to Notice Letter 03-12-12
Riteaway ~~32E-223~~, ~~32J-203~~, 32J-403, 32M-243
NENW-32-5N-67W, Weld County, CO

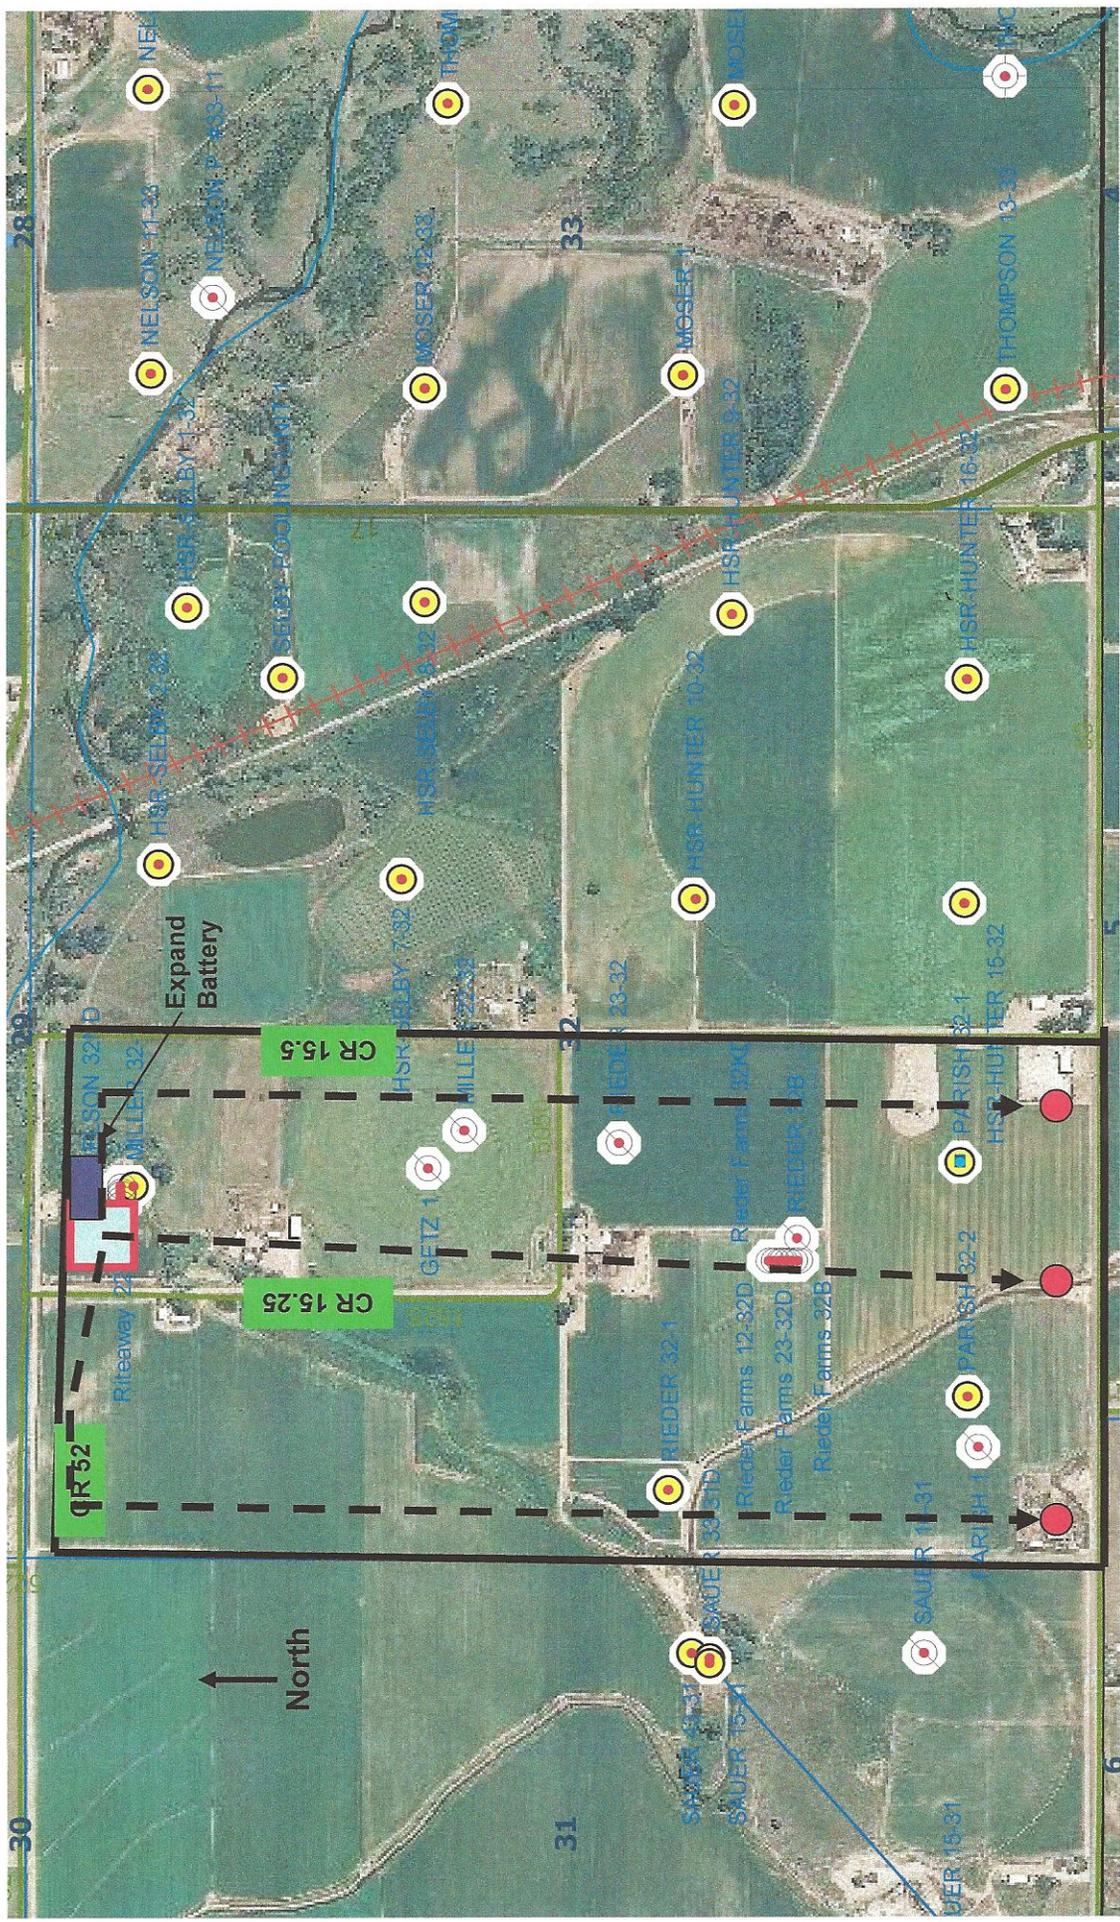

Approx. SHL: ~~32E-223~~ = 242 FNL, 1746 FWL
~~32J-203~~ = 267 FNL, 1762 FWL
 32J-403 = 292 FNL, 1778 FWL
 32M-243 = 317 FNL, 1794 FWL

● BHL: ~~32E-223~~ = 500 FSL, 500 FWL
~~32J-203~~ = 500 FSL, 1320 FWL
 32J-403 = 500 FSL, 1320 FWL
 32M-243 = 500 FSL, 2130 FWL

PDC leasehold
 W/2-32-5-67

32E-323
 32J-103

Surface Owner: Rite A Way Industries c/o Josh O'Donn
Phone #: 910-556-5231 32J-103
Well Name(s): Riteaway ~~32J-203, 32J-403, 32E-223~~
32M-243 32E-323

Check Appropriate Box(s):

- I do not want a consultation.
- I do want to be consulted concerning proposed operations.
- I want to appoint a Tenant to be consulted.

Tenant

Name: to N/A
Phone #: _____
Address: _____