


SITE SKETCH

RITEAWAY 32J-403

SECTION: 32
TOWNSHIP: 5N
RANGE: 67W

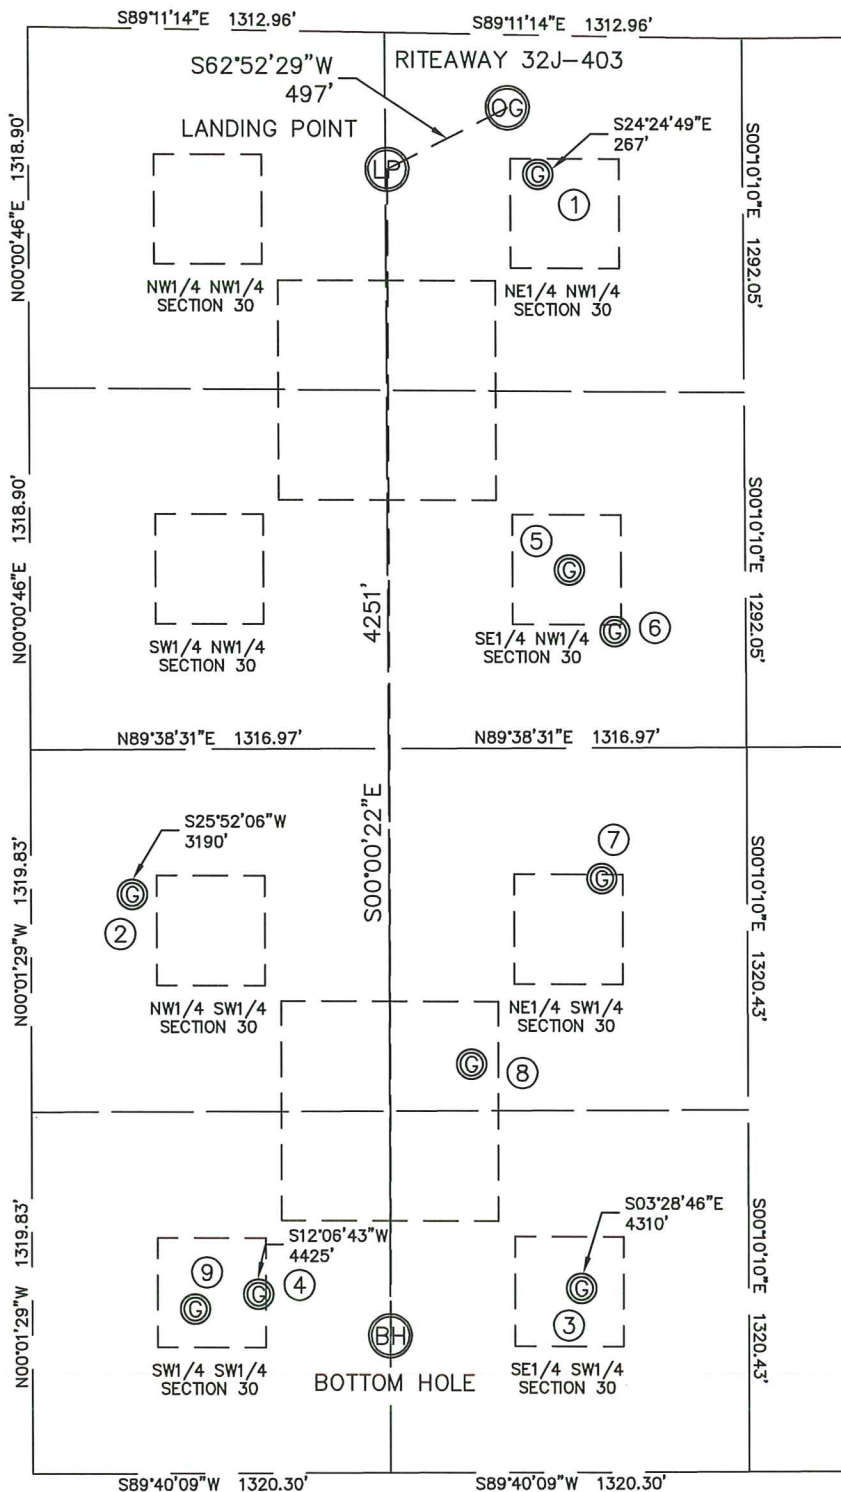

①

MILLER 32-1
NE1/4 NW1/4
S00°48'46"W 508' FNL
S89°59'14"E 1872' FWL
LAT-40.36203°N
LONG-104.91981°W
PDOP: 5.0
ELEV: 4794'

⑤

GETZ #1
(ABANDONED LOCATION
PER COGCC MAP)
SE1/4 NW1/4
1949' FNL (PER PLAT)
1983' FWL (PER PLAT)

②

RIEDER 32-1
NW1/4 SW1/4
N00°19'51"W 2112' FSL
N89°58'31"E 370' FWL
LAT-40.35485°N
LONG-104.92526°W
PDOP: 2.1
ELEV: 4839'

⑥

MILLER 22-32
(ABANDONED LOCATION
PER COGCC MAP)
SE1/4 NW1/4
2170' FNL (PER PLAT)
2150' FWL (PER PLAT)

③

PARISH 32-1
SE1/4 SW1/4
N00°19'51"W 671' FSL
N89°58'31"E 2023' FWL
LAT-40.35089°N
LONG-104.91936°W
PDOP: 3.0
ELEV: 4830'

⑦

RIEDER 23-32
(ABANDONED LOCATION
PER COGCC MAP)
NE1/4 SW1/4
2165' FSL (PER PLAT)
2100' FWL (PER PLAT)

④

PARISH 32-2
SW1/4 SW1/4
N00°19'51"W 654' FSL
N89°58'31"E 833' FWL
LAT-40.35084°N
LONG-104.92363°W
PDOP: 2.3
ELEV: 4850'

⑧

RIEDER 32B
(ABANDONED LOCATION
PER COGCC MAP)
NE1/4 SW1/4
1490' FSL (PER PLAT)
1620' FWL (PER PLAT)

⑨

NO. 1 PARISH
(ABANDONED LOCATION
PER COGCC MAP)
SW1/4 SW1/4
600' FSL (PER PLAT)
600' FWL (PER PLAT)

NOTE
BEARINGS AND DISTANCES AT EXISTING
WELLS ARE CALCULATED FROM THE
PROPOSED LOCATION TO THE EXISTING WELL.

